GLENN P. POGUE
RANGE 19, TOWNSHIP 2, QUARTER TOWNSHIP 1, U.S.M.,
CITY OF COLUMBUS, FRANKLIN COUNTY, STATE OF OHIO

Scale 1" = 100 Date 4-4-1981 P.B. ____ P. ____ D.V. 5400 P. 547 Lot No. ____

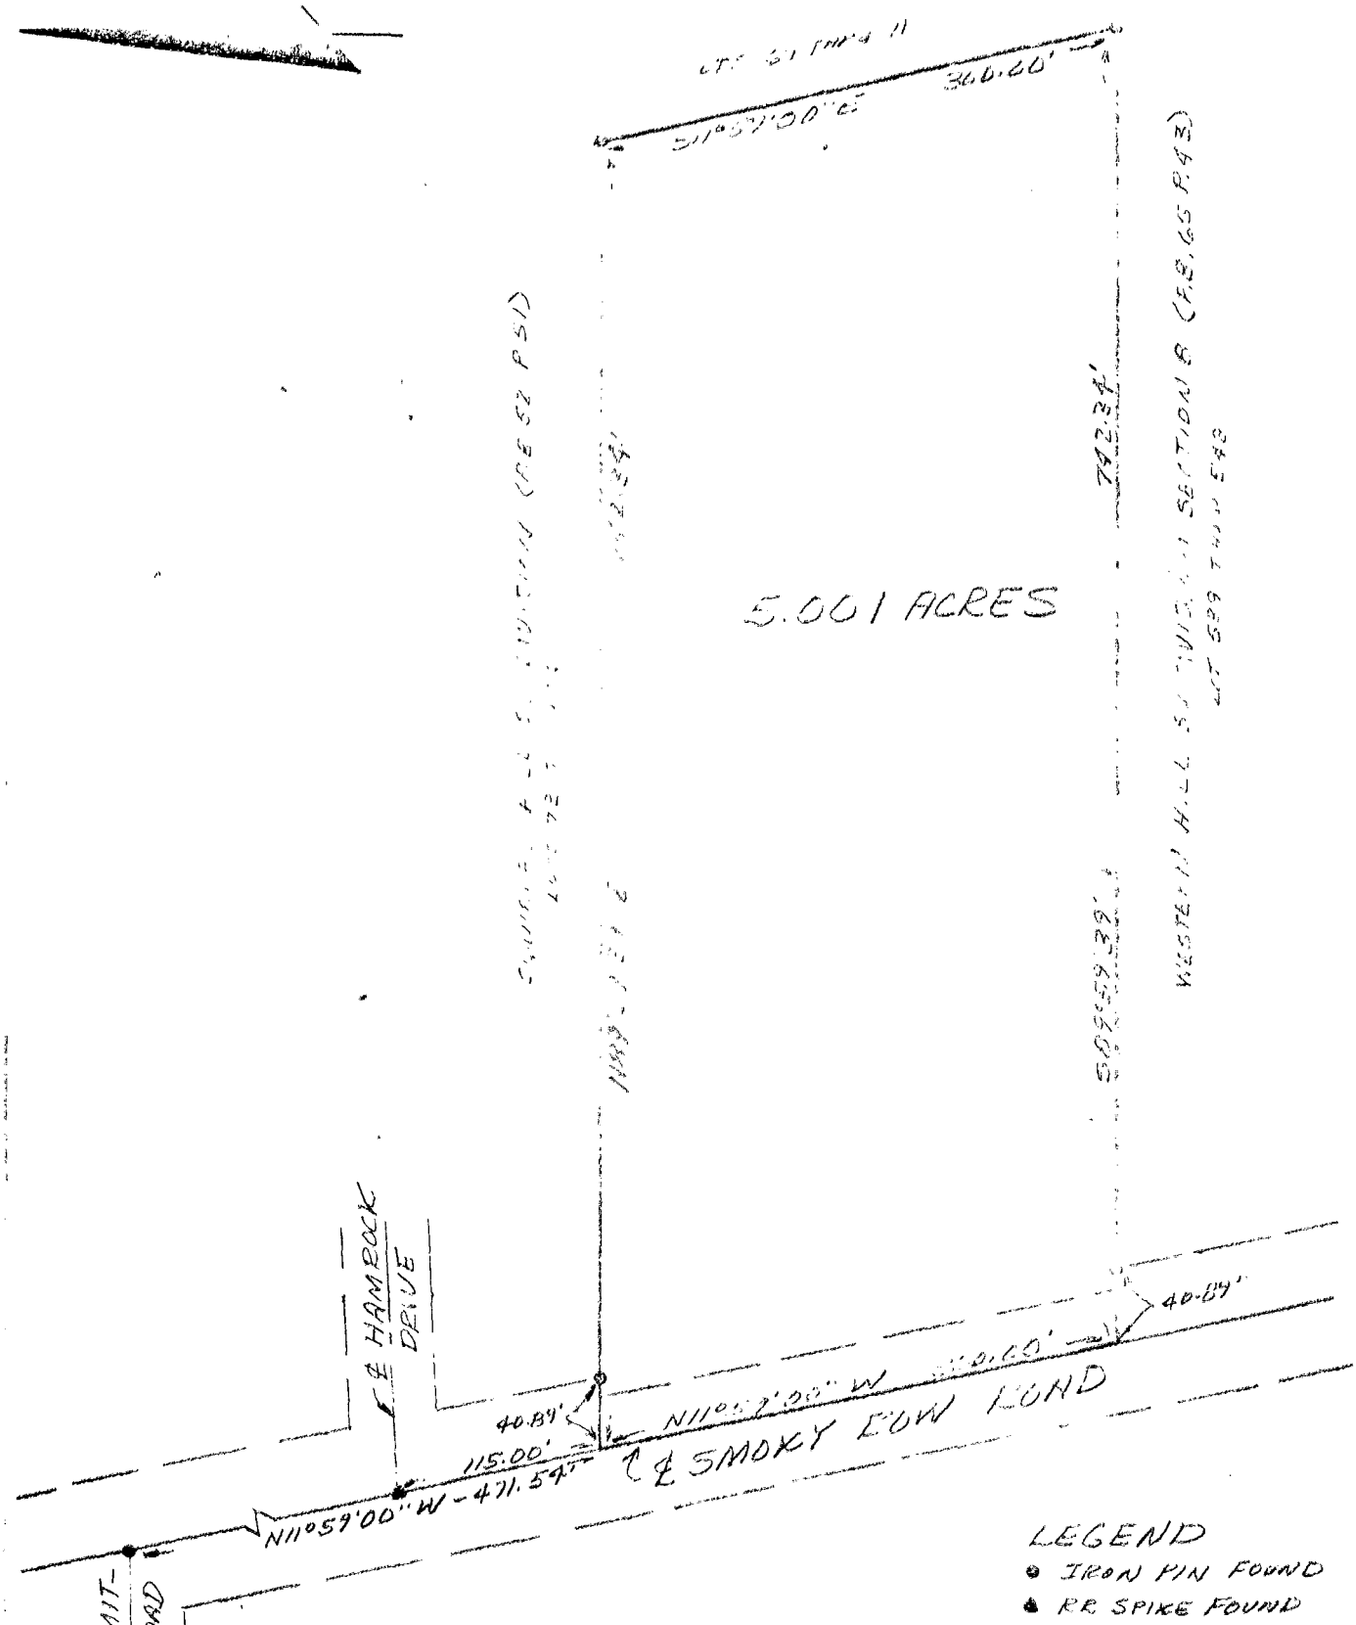

I hereby certify that the foregoing drawing was prepared from an actual survey of the premises.

Drawn by ____

Samuel W. Vance

Registered Surveyor No. 6553

VANCE SURVEYING