BAUER, BOROWITZ & MERCHANT, INC.

CONSULTING ENGINEERS

2607½ NORTH HIGH STREET COLUMBUS, OHIO 43202

SURVEY MAP OF ACREAGE PARCELS LOCATED AT THE NORTHEASTERLY CORNER OF QUEENSBRIDGE DRIVE AND SMOKY ROW ROAD IN THE CITY OF COLUMBUS, COUNTY OF FRANKLIN, STATE OF OHIO

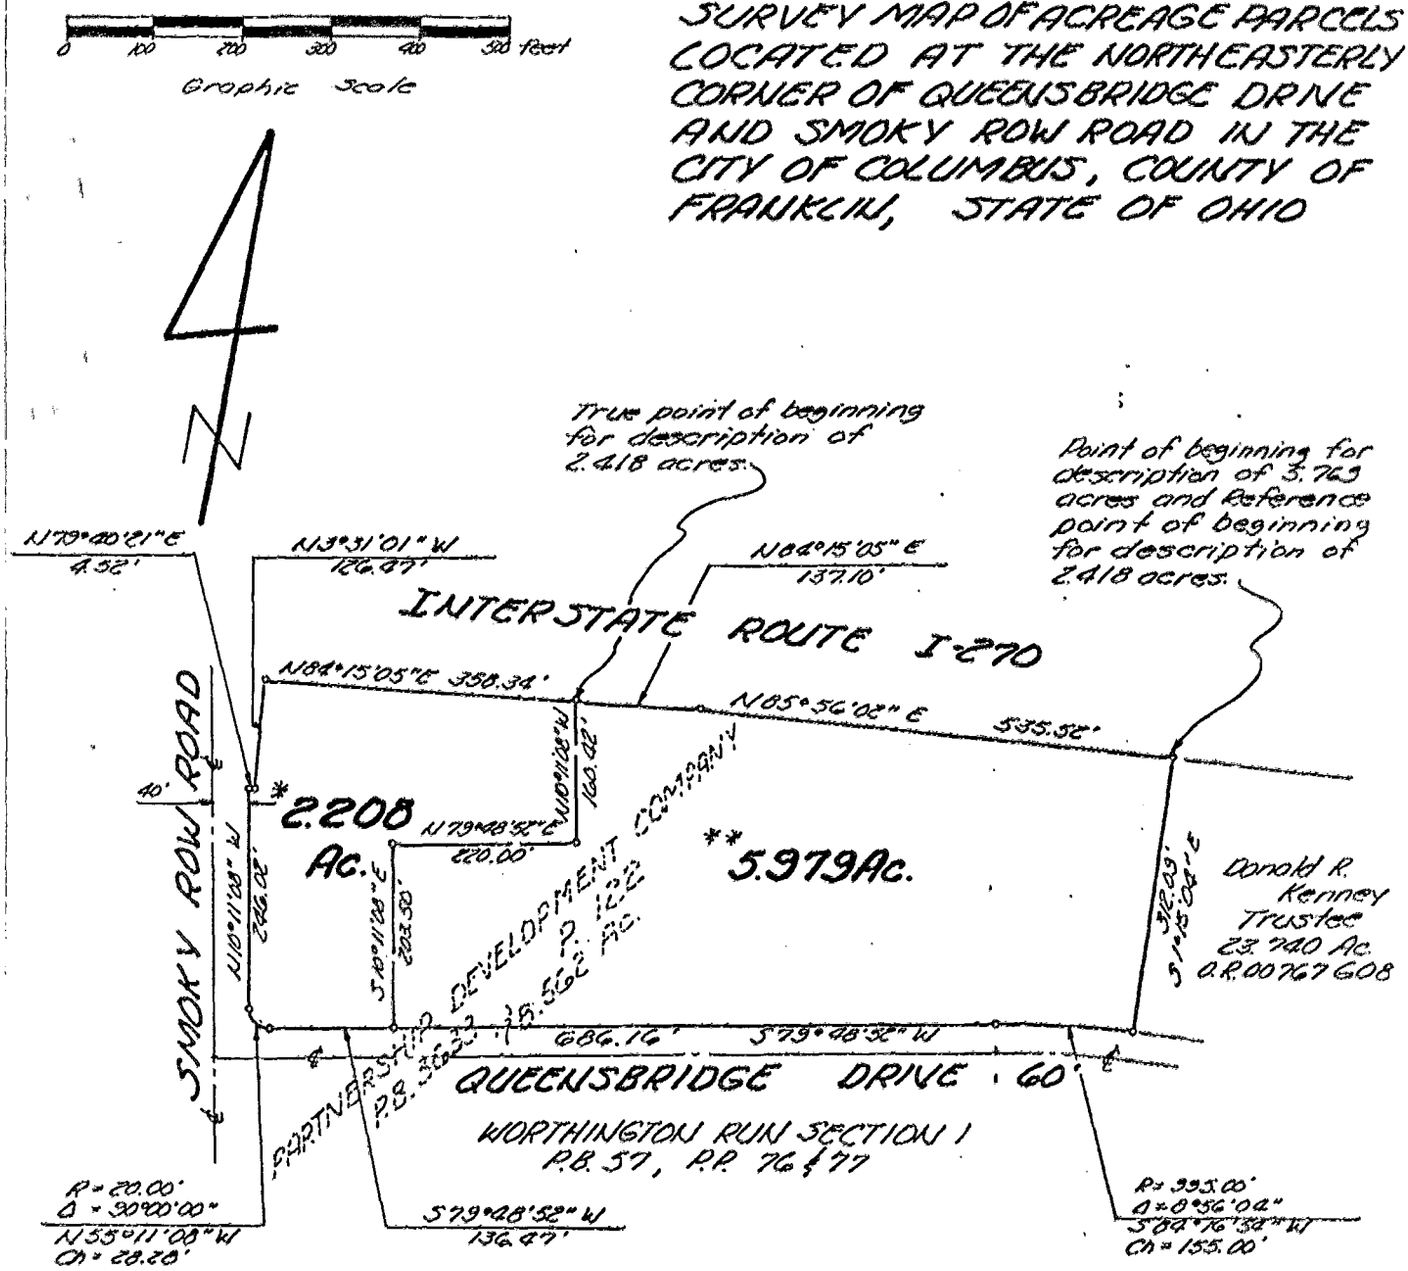

*Situated in the State of Ohio, County of Franklin, City of Columbus, being in Lots 5 and 6 as the same are numbered and delineated upon the recorded plat of Floyd Tullers Survey of Section 1, Township 2, Range 19, United States Military Lands of record in Plat Book 3, Page 60 containing 2.208 acres of land, more or less, said 2.208 acres being a part of that 78.562 acre tract of land described in the deed to the Partnership Development Company of record in Deed Book 3623, Page 122, Recorder's Office, Franklin County, Ohio.

**Situated in the State of Ohio, County of Franklin, City of Columbus, being in Lots 5 and 6 as the same are numbered and delineated upon the recorded plat of Floyd Tullers Survey of Section 1, Township 2, Range 19, United States Military Lands of record in Plat Book 3, Page 60 containing 5.979 acres of land, more or less, said 5.979 acres being a part of that 78.562 acre tract of land described in the deed to the Partnership Development Company of record in Deed Book 3623, Page 122, Recorders Office, Franklin County, Ohio.

We hereby certify that the above map was prepared from information obtained from an actual field survey conducted by Bauer, Borowitz & Merchant, Inc. in December of 1982, and that, to the best of our knowledge and belief, said map is correct.

The bearings shown on the above map correspond to the bearings shown on said record plat of Worthington Run Section 1.

—o— designates iron pipe

Bauer, Borowitz & Merchant, Inc.
Consulting Engineers

By William W. Merchant
William W. Merchant
Registered Surveyor No. 4863

December 7, 1982 Scale: 1" = 200'
Order No. 1562-82
Revised December 8, 1982

82-093