

# DPH SURVEYING

P.O. Box 429 Thornville, Ohio 43076

TELEPHONE: 614-864-9925

FAX NO.: 614-864-9934

OHIO PHONE: 1-800-648-8111




## PROPERTY LOCATION

SITUATED IN QUARTER TOWNSHIP 1, TOWNSHIP 2N,  
RANGE 13W, UNITED STATES MILITARY LANDS  
CITY OF COLUMBUS, FRANKLIN COUNTY, OHIO, AND  
BEING A PART OF LOT 15 OF FLAVEL TULLER'S  
SURVEY, AS RECORDED IN PLAT BOOK 2, PAGE 60,

## PREPARED FOR

WADE HATHAWAY

Z 90-013 A

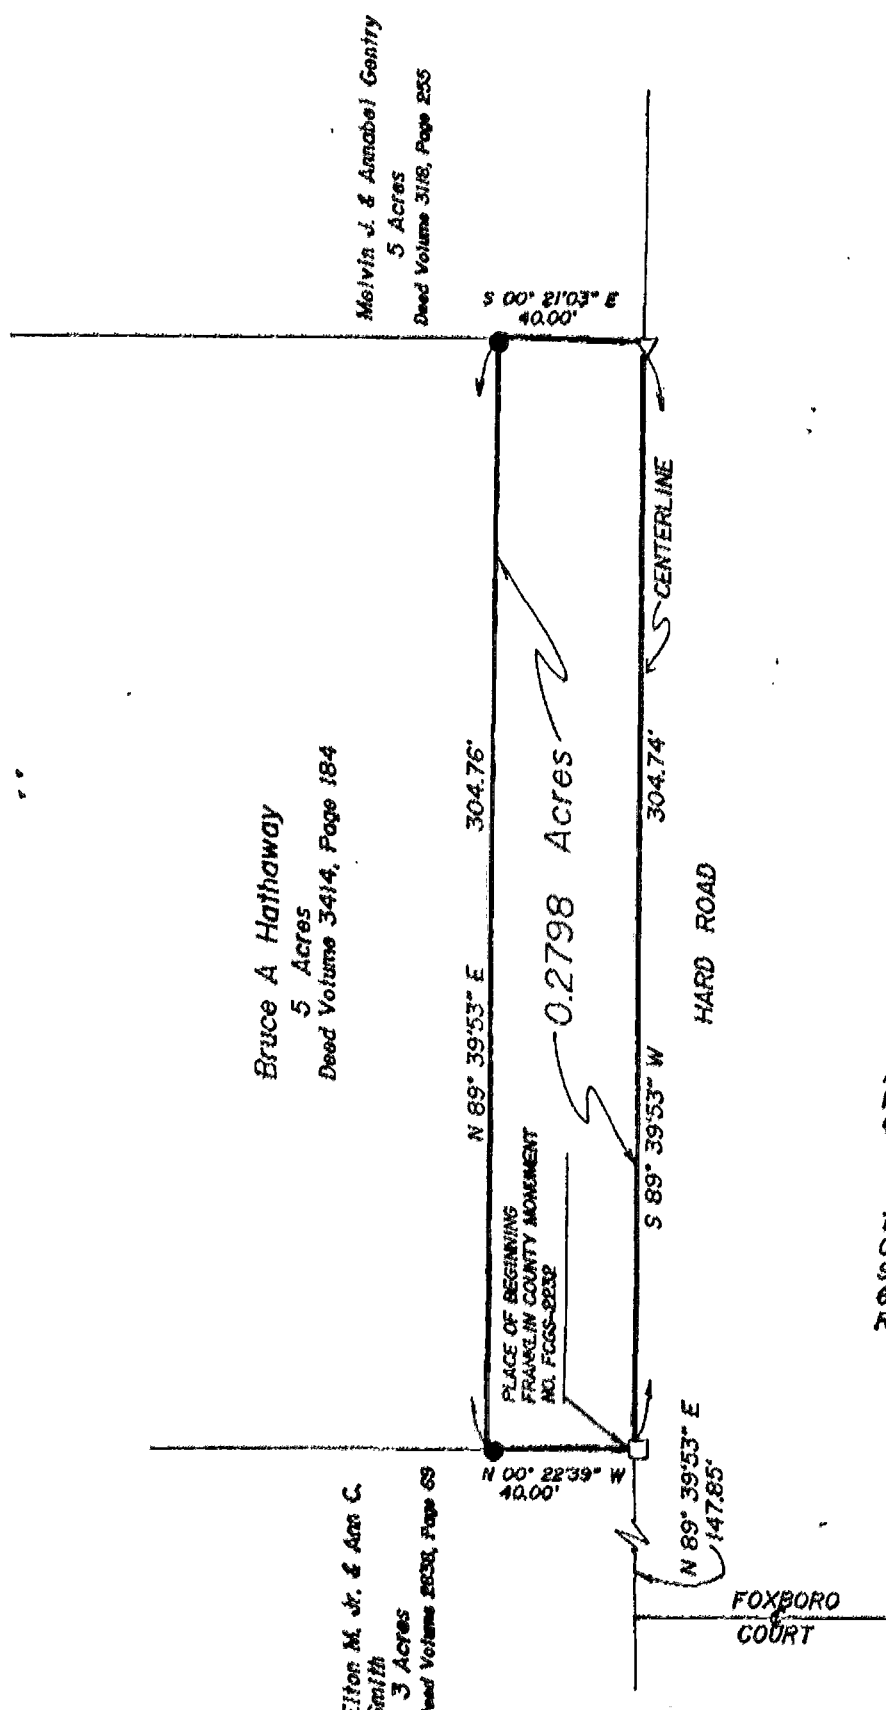

SCALE 1" = 50'



### LEGEND

- - IRON PIN SET
- △ - RAILROAD SPIKE FOUND
- - MONUMENT FOUND

ALL IRON PINS SET ARE 5/8" O.D. REINFORCING BARS WITH YELLOW CAPS LABELED "DENNIS HAGAN #6917".


THE BEARINGS OF THIS PLAT ARE BASED ON THE PLAT OF OLDE SAWMILL SUB. SECTION 11, AS RECORDED IN PLAT BOOK 62, PAGE 54, IN THE FRANKLIN COUNTY RECORDER'S OFFICE.

I HEREBY CERTIFY THAT A SURVEY WAS MADE OF THE PREMISES AND THAT THE ATTACHED PLAT IS CORRECT TO THE BEST OF MY KNOWLEDGE.

DATE 11/14/90

*Dennis P. Hagan*

DENNIS P. HAGAN, P.E., P.S.  
OHIO REGISTERED SURVEYOR #6917

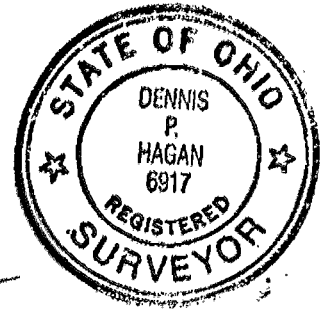

0-2-E