

Myers Surveying Company, Inc.

2740 East Main Street, Columbus 43209 (Bexley), Ohio
 614-235-8677 FAX: 614-235-4559

A Mortgage Location Survey prepared for and certified to:

Cardinal Title Agency, Inc. and/or Huntington Mortgage Company

Legal Description: Situated in Ohio, County of Franklin, City of Dublin, Being Part of Lot 142 Shannon Park Section 2, Phase 2, Plat Book 61, Page 72

Applicant: Zack

Posted Address: 6872 Gullway Bay Dr., Dublin, Ohio


F.E.M.A. Flood Zone Designation: Flood Zone "C" as per F.I.R.M. 390673 0006 D.

Apparent Encroachments: 1) Fences not in conformance with legal description. 2) Concrete Over Property Line.



Scale: 1" = 20'

Date: 11-27-'92

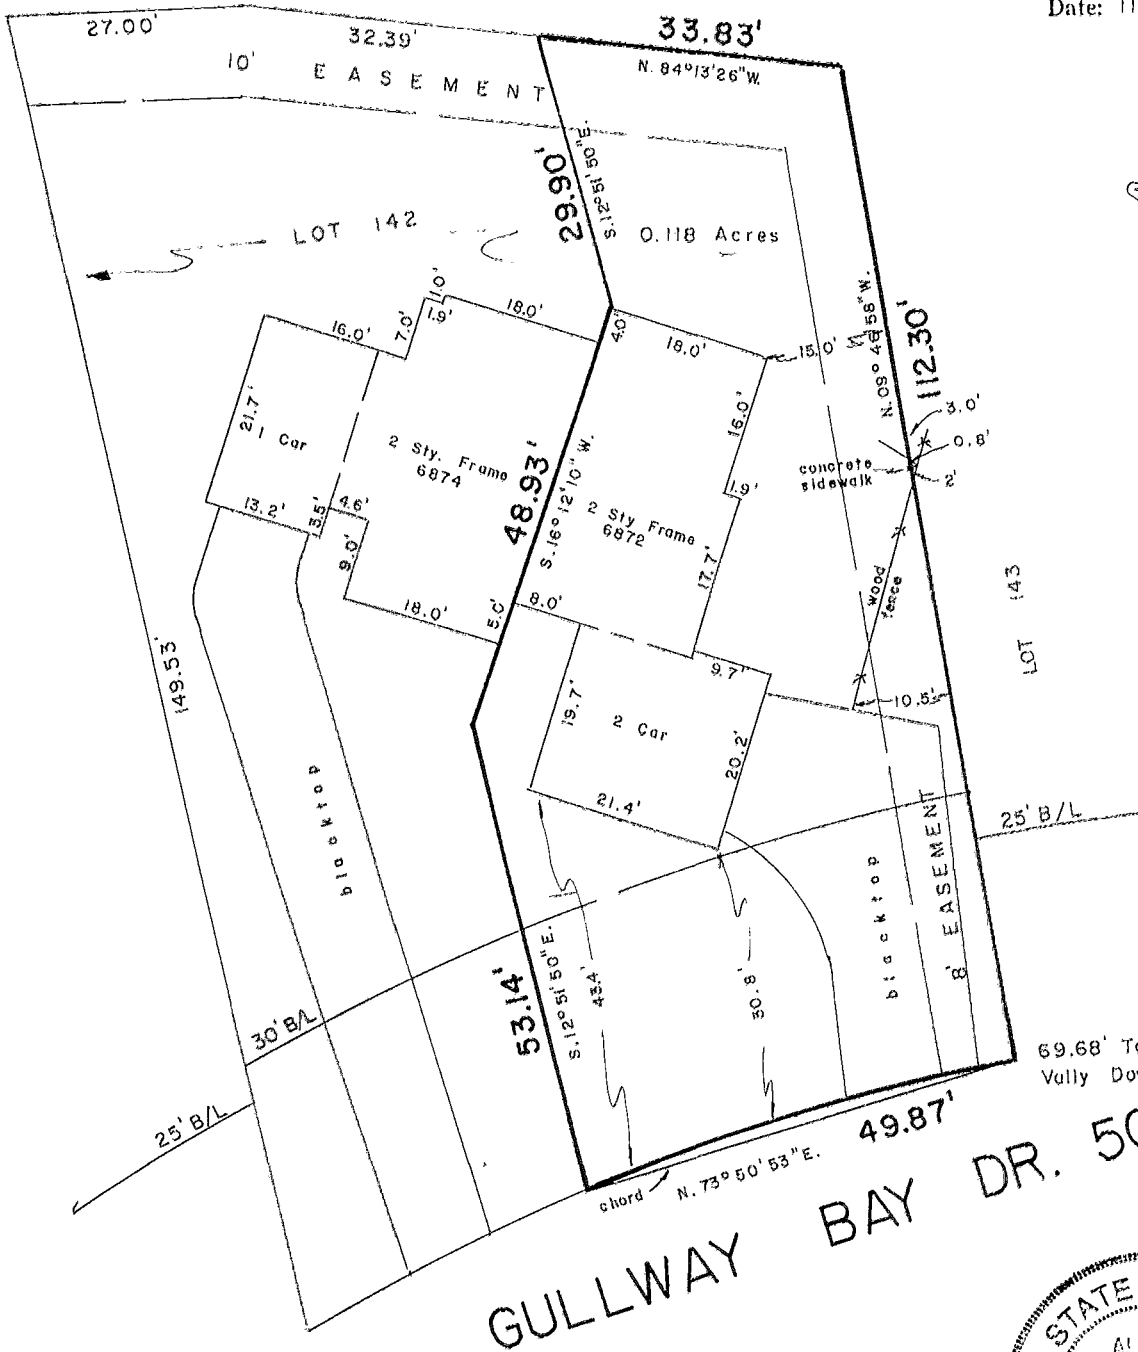

69.68' To P.C. Vally Down Rd.

GULLWAY BAY DR. 50'

KJ-9C-1AAAA



Myers Surveying Co., Inc.

By Albert Myers
 Professional Surveyor

We hereby certify that the foregoing Mortgage Location survey was prepared from actual field measurements in accordance with Chapter 4733-38 Ohio Administrative Code, and is not a boundary survey pursuant to Chapter 4733-37 of said code.
THE INFORMATION SHOWN HEREON IS NOT TO BE UTILIZED FOR THE INSTALLATION OF BUILDINGS, FENCES, LANDSCAPING OR OTHER PERMANENT IMPROVEMENTS.