

EVANS MECHWART HAMBLETON & TILTON, INC.

CONSULTING ENGINEERS - SURVEYORS
GAHANNA, OHIO

180607675
181507610

LOTS 139 & 140

BROOKSIDE COLONY


N-58-JTTJ

CITY OF COLUMBUS, FRANKLIN COUNTY, OHIO

SCALE 1" = 20'

IRON PIN
NOVEMBER 12, 1986

DEED BOOK _____, PAGE _____
PLAT BOOK 55, PAGE 88

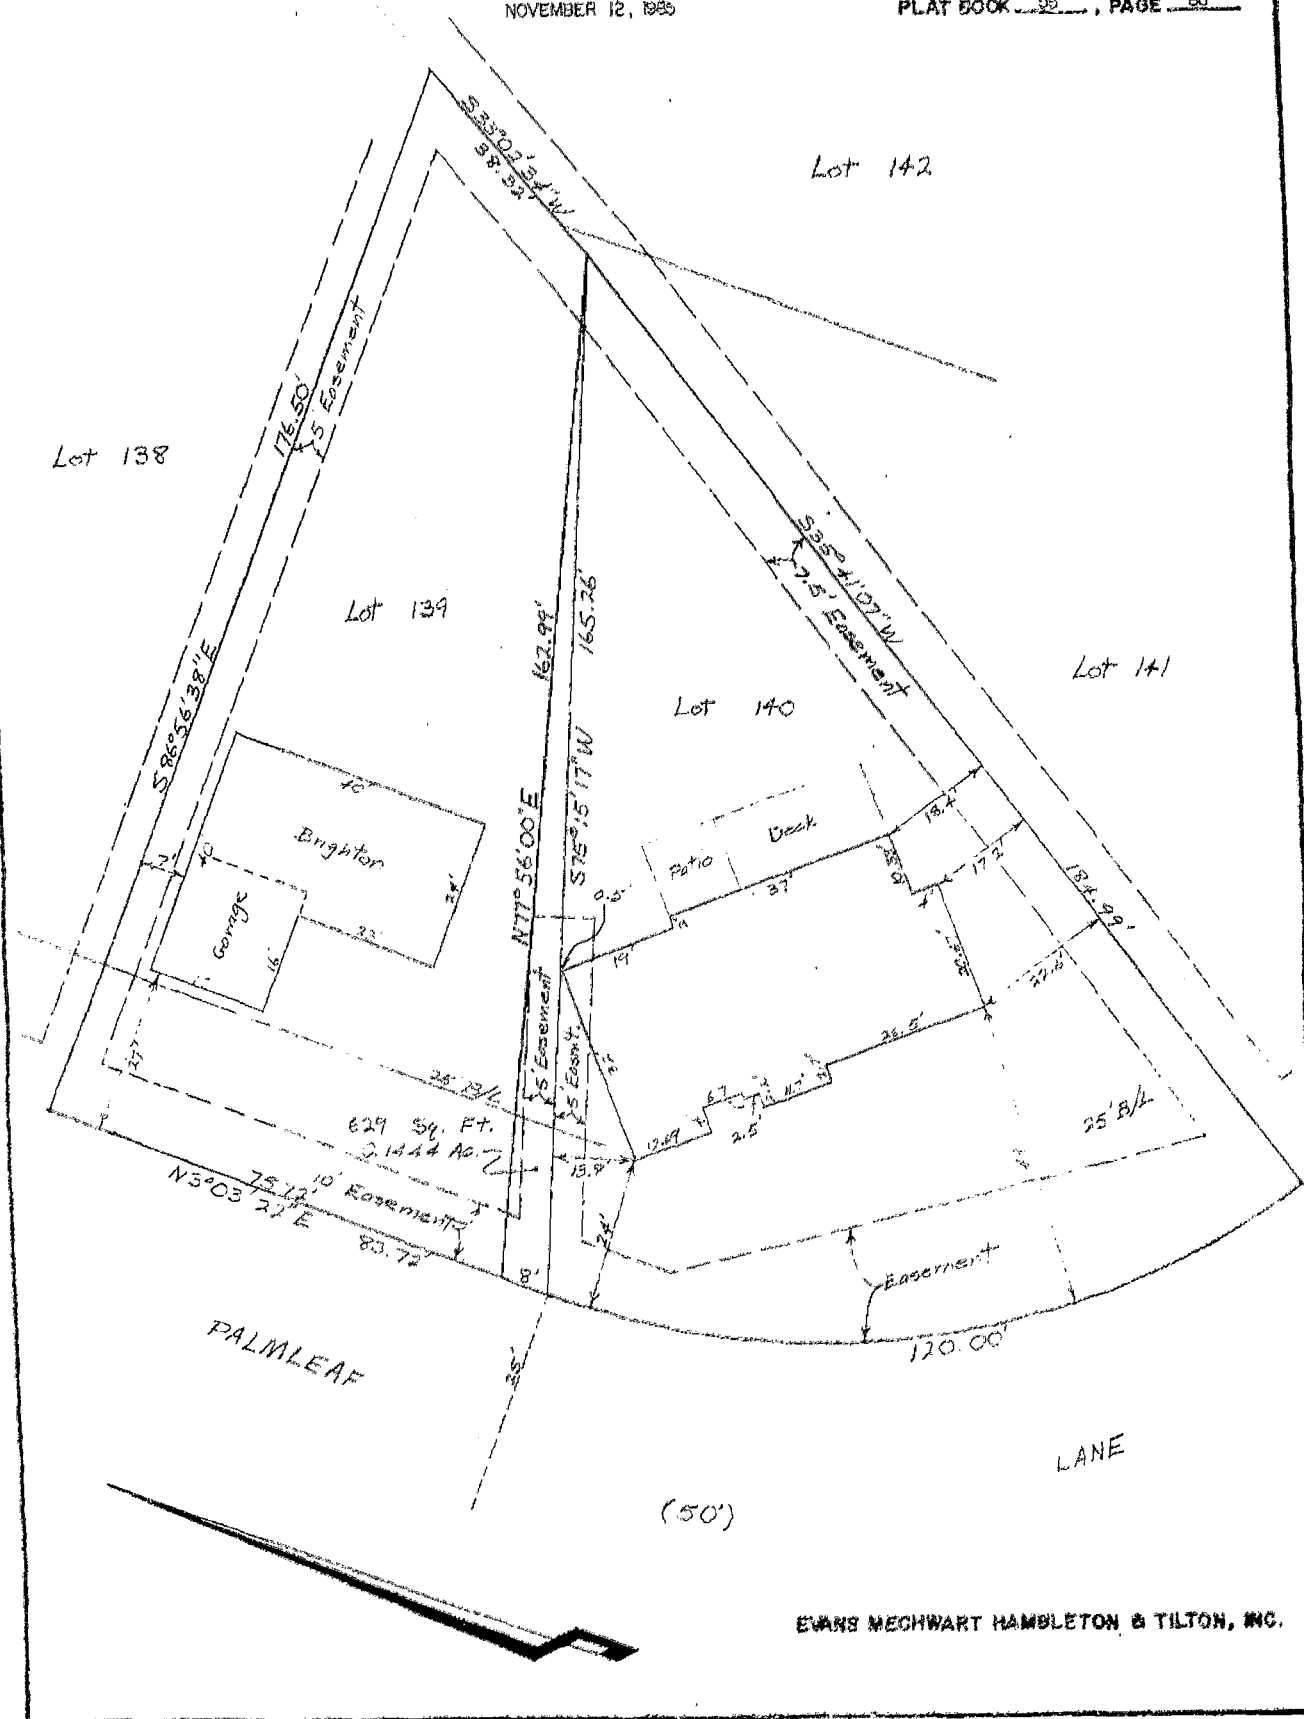

EVANS MECHWART HAMBLETON & TILTON, INC.