# BAUER, BOROWITZ & MERCHANT, INC.

CONSULTING ENGINEERS

2607½ NORTH HIGH STREET COLUMBUS, OHIO 43202

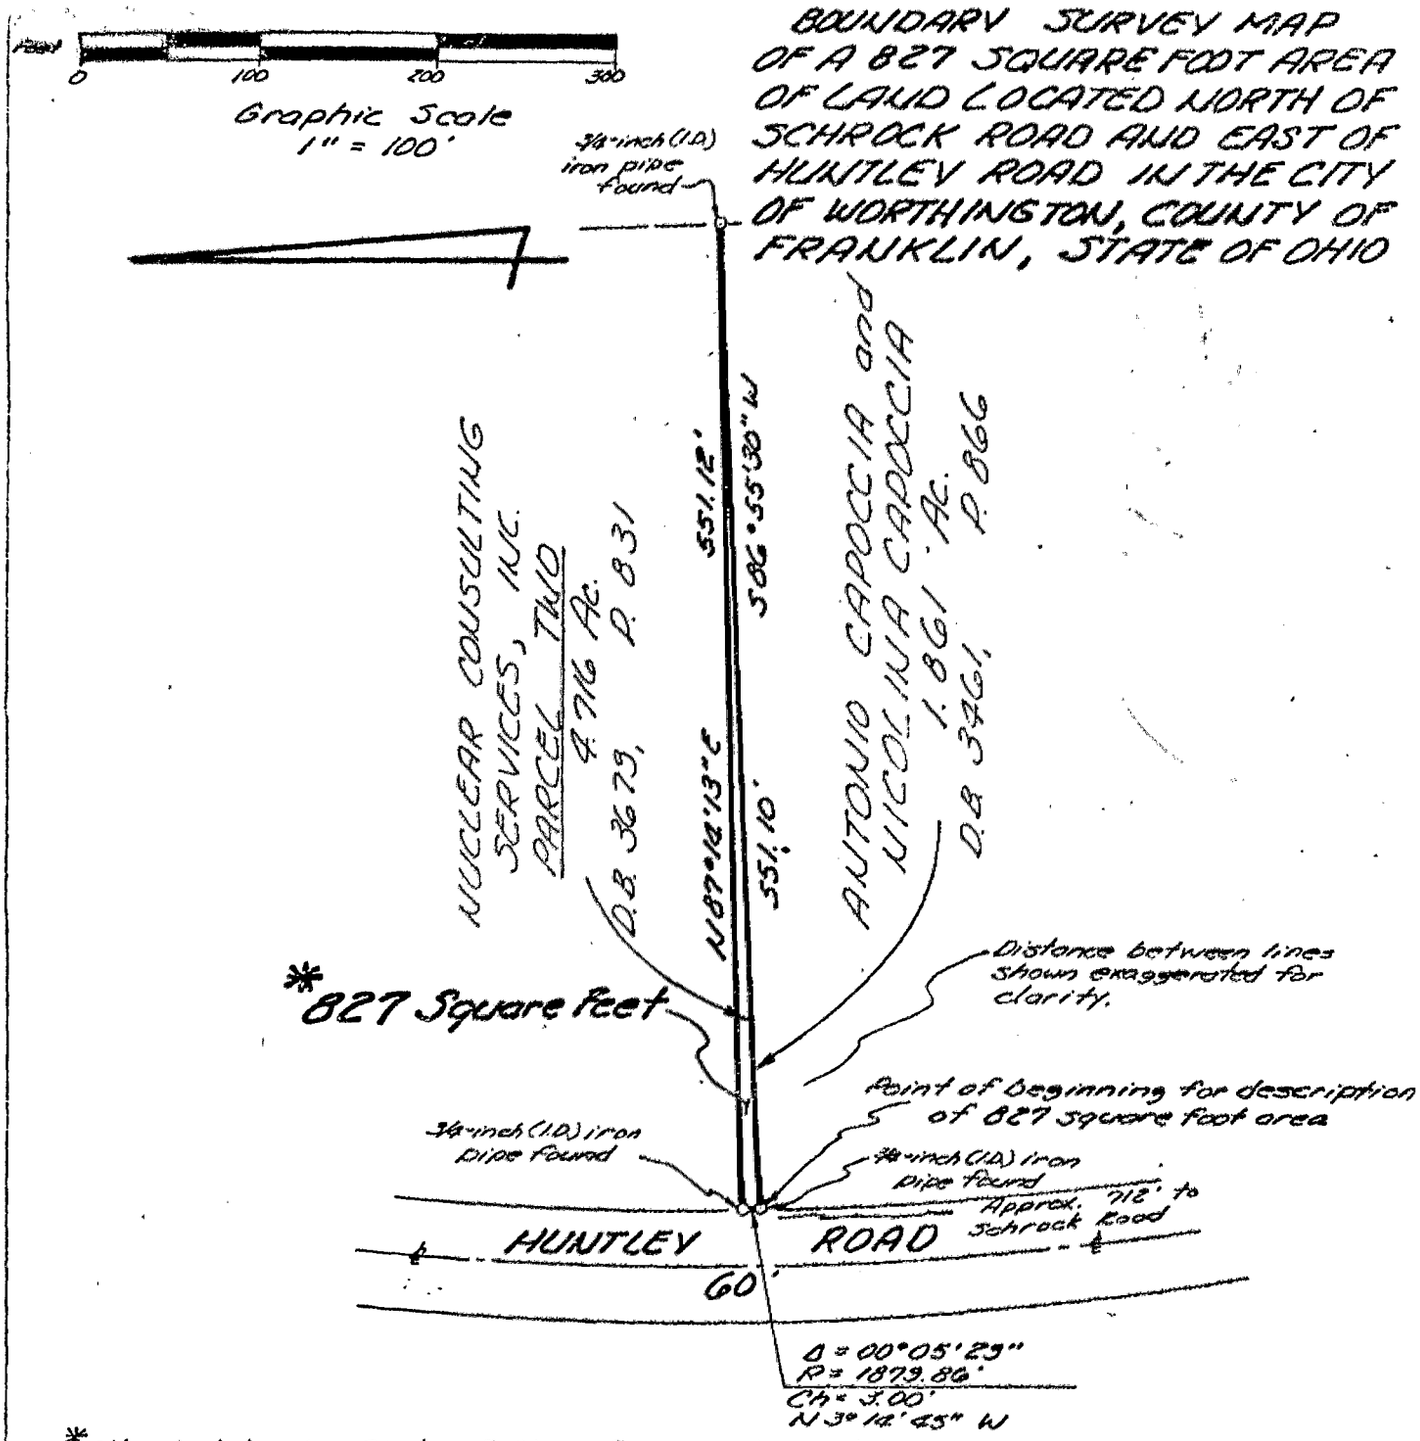


*Situated in the State of Ohio, County of Franklin, City of Worthington being located in Farm Lots 67 and 68 of Quarter Township 2, Township 2, Range 18, United States Military Lands and being a 827 square foot area of land, more or less, said 827 square foot area being out of that 4.716 acre tract of land designated as PARCEL TWO and described in the deed to Nuclear Consulting Services, Inc. of record in Deed Book 3679, Page 831, Recorder's Office, Franklin County, Ohio.

We hereby certify that the above map was prepared from information obtained from an actual field survey conducted by Bauer, Borowitz & Merchant, Inc. in January of 1983, and that, to the best of our knowledge and belief, said map is correct.

The survey marker noted on the above map and described as "set" was set by Bauer, Borowitz & Merchant, Inc. The survey markers noted on the above map and designated as "found" were set by others. All of the survey markers noted on this map were in place on January 12, 1983.

The bearings shown on the above map are based on an assumed meridian.

Bauer, Borowitz & Merchant, Inc.
Consulting Engineers

March 11, 1983

Order No. 1028-82

By _____
Robert W. Davidson
Registered Surveyor No. 5722

EXHIBIT "B"

#1028-82