N-236.

SURVEY PLAT

PORTIONS OF LOTS 24 & 25 OF THE NORTH HOME ACRE PARK ADDITION PLAT BOOK 18 AT PAGE 20 AND
PORTIONS OF LOTS 120, 121, 122 AND 123 OF THE NORTH HOME ACRE PARK ADDITION AMENDED PLAT
No. 2 PLAT BOOK 20 AT PAGE 2.
CITY COLUMBUS, COUNTY OF FRANKLIN, STATE OF OHIO

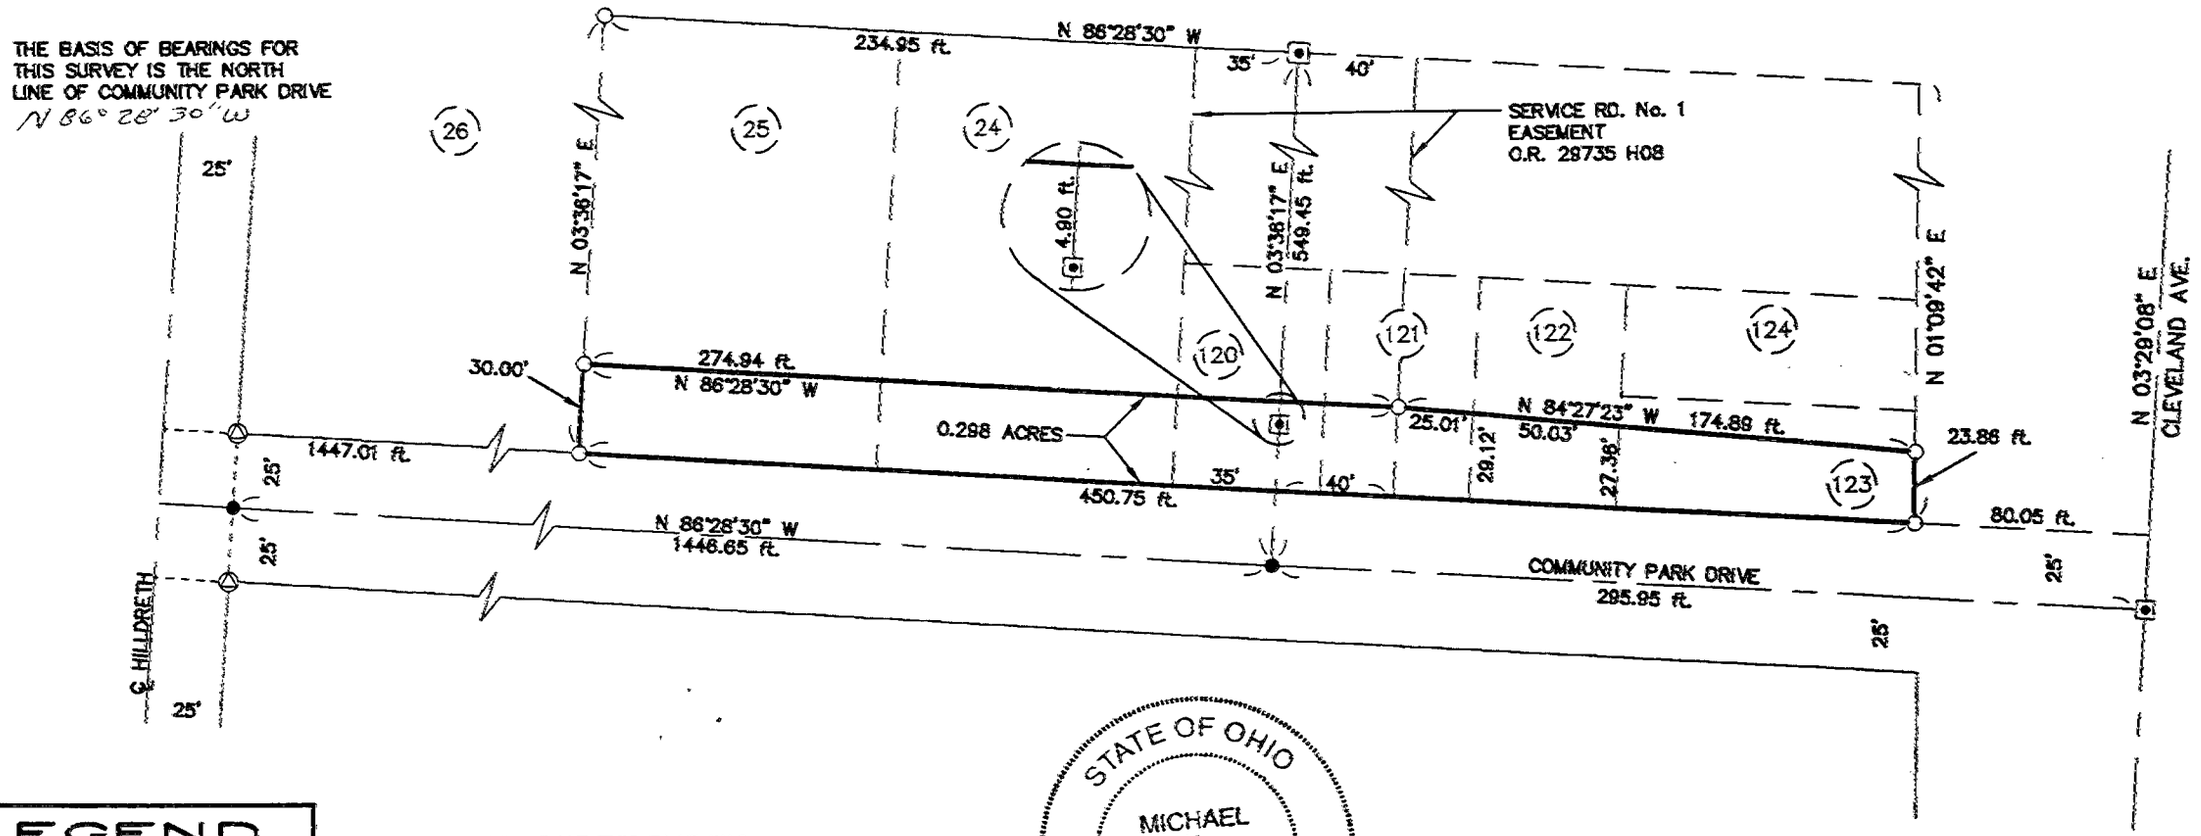

LEGEND

- ○ SET 5/8" x 30" IRON REBAR WITH PLASTIC CAP LABELED "MS CONS INC."
- ⊡ FOUND 5/8" IRON REBAR IN OHIO DEPARTMENT OF TRANSPORTATION MONUMENT ASSEMBLY BOX
- ● FOUND PK NAIL
- ⏢ FOUND 3/4" IRON REBAR

I CERTIFY THAT THIS PLAT WAS PREPARED FROM AN ACTUAL FIELD SURVEY COMPLETED IN AUGUST OF 1995.

9-05-95

MICHAEL K. AUSTEN P.S. No. 7546

STATE OF OHIO
MICHAEL K. AUSTEN
S-7546
REGISTERED
PROFESSIONAL SURVEYOR

PREPARED BY
ms consultants, inc.
CONSULTING ENGINEERS & PLANNERS
6500 BUSCH BOULEVARD, COLUMBUS, OHIO

SCALE: 1" = 60'