

# BAUER, DAVIDSON & MERCHANT, INC.

18167500

CONSULTING ENGINEERS

2607½ NORTH HIGH STREET

COLUMBUS, OHIO 43202


**BOUNDARY SURVEY MAP OF A 0.930 ACRE TRACT OF LAND LOCATED ON THE EAST SIDE OF JASONWAY AVENUE AND NORTH OF KNIGHTS-BRIDGE BOULEVARD, IN THE CITY OF COLUMBUS, COUNTY OF FRANKLIN, STATE OF OHIO**

February 15, 1986

Scale: 1" = 40'

Order No. 768-85

M-182-EE

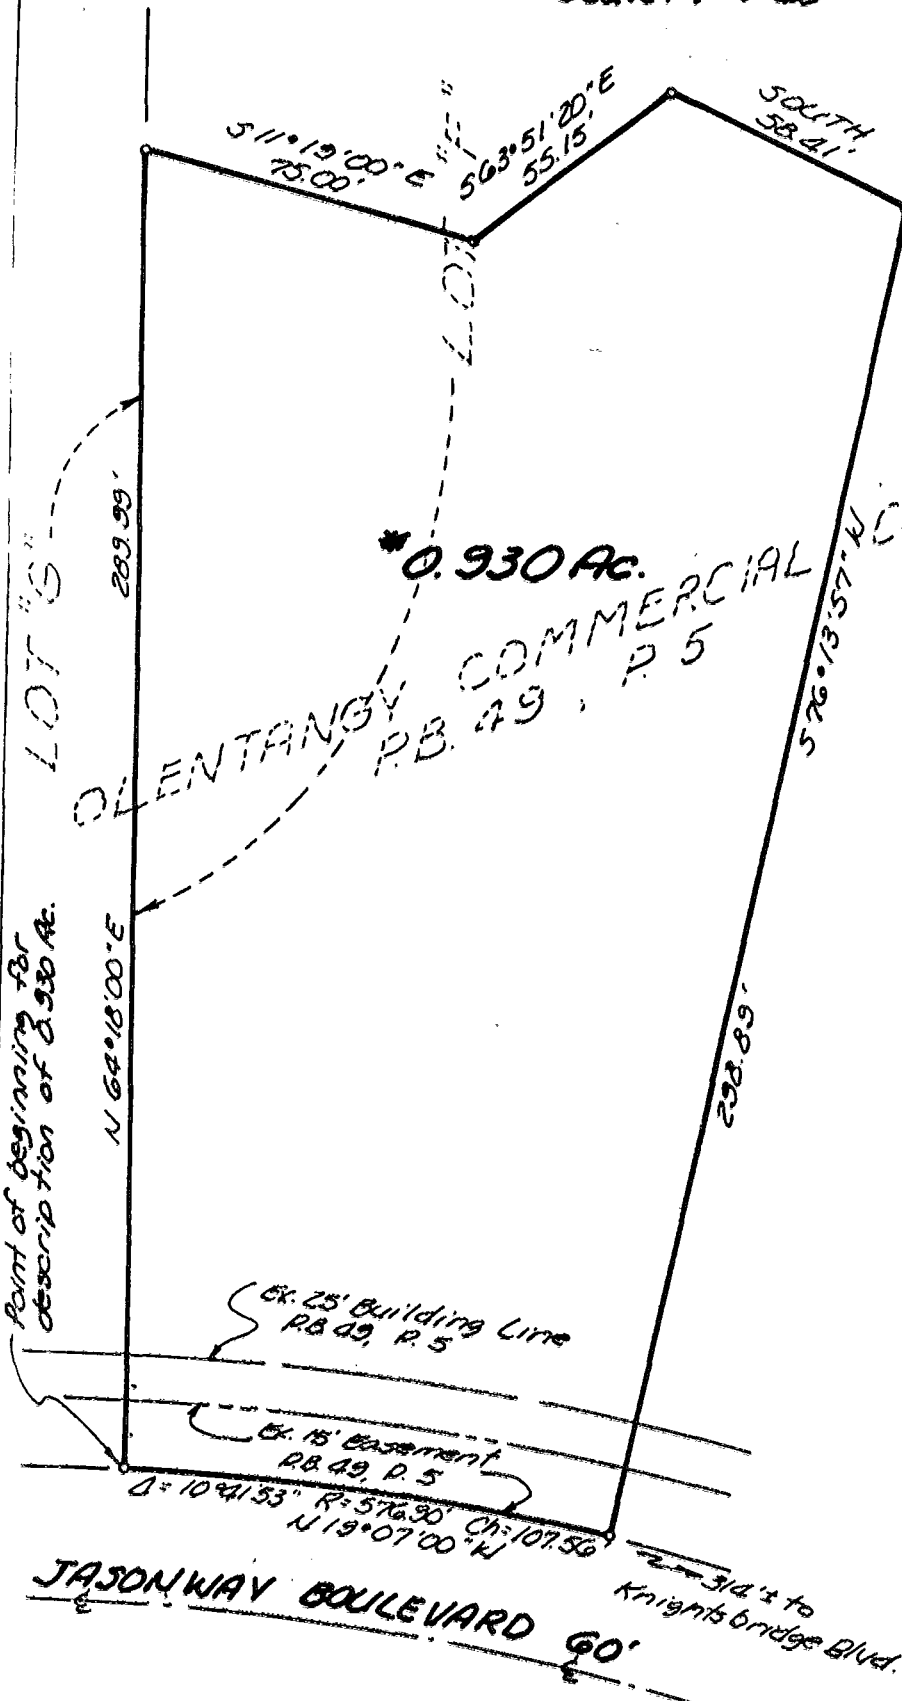

Situated in the State of Ohio, County of Franklin, City of Columbus, located in Quarter Township & Township 1, Range 18, United States Military Land's containing a 0.930 acre tract of land, more or less said 0.930 acre being part of Lot "S" as the same is shown and delineated upon the recorded plat of Olen tangy Commercial Center, Franklin County, Ohio.

The bearings shown on the above map are based on the bearings shown on the recorded plat of said Olen tangy Commercial Center.

We hereby certify that the above map was prepared from information obtained from an actual field survey conducted by Bauer, Davidson & Merchant, Inc. on February 14, 1986.

**Bauer, Davidson & Merchant, Inc.**  
 Consulting Engineers  
 By William W. Merchant  
 Professional Surveyor No. 8943

Indicates ¾-inch (1.0) iron pipe unless otherwise noted

M-182-EE 010-73629