


BAUER, DAVIDSON & MERCHANT, INC.

CONSULTING ENGINEERS


255 GREEN MEADOWS DRIVE SOUTH P.O. BOX 370 POWELL OHIO 43065

MAP SHOWING THE SPLIT OF LOT 119 IN LINWORTH VILLAGE SECTION ONE LOCATED ON THE WESTERLY SIDE OF CASTLE PINES, IN THE CITY OF COLUMBUS, COUNTY OF FRANKLIN, STATE OF OHIO

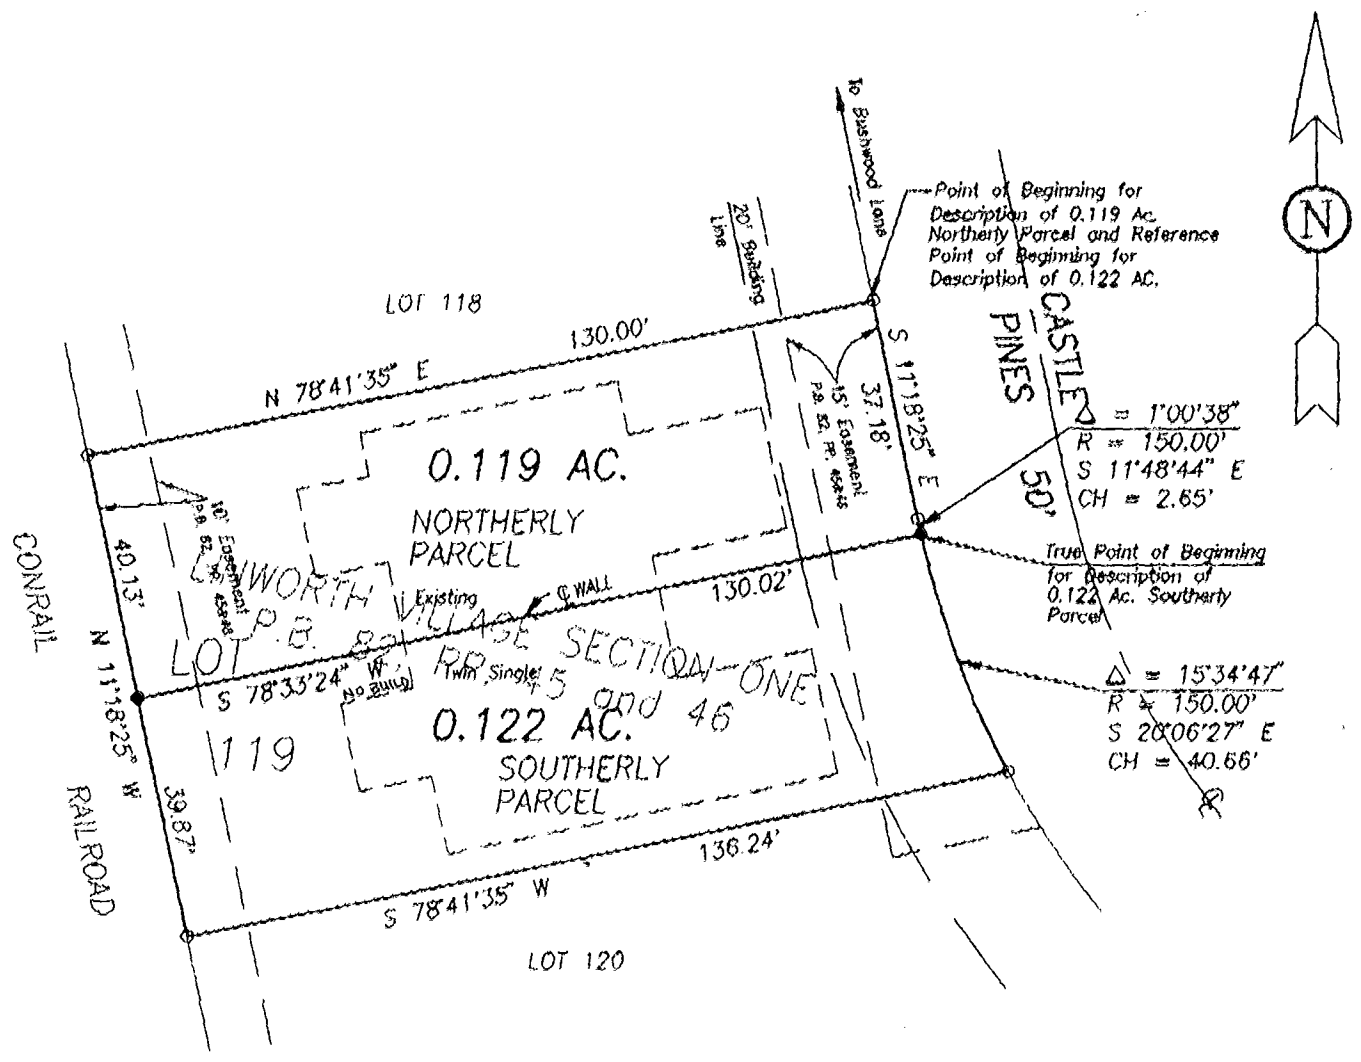

GRAPHIC SCALE

- 3/4-inch(I.D.) iron pipe set
- 3/4-inch(I.D.) iron pipe found

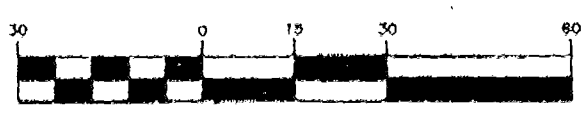

(IN FEET)
1 inch = 30 ft

Situated in the State of Ohio, County of Franklin, City of Columbus, being in Quarter Township 4, Township 2, Range 19, United States Military Lands and being a 0.119 acre and 0.122 acre areas of land, more or less, said 0.119 acre and 0.122 acre areas being all of Lot 119, as the same is numbered and delineated upon the recorded plat of Linworth Village Section One, of record in Plat Book 82, Pages 45 and 46, Recorder's Office, Franklin County, Ohio.

We hereby state that this map was prepared from information obtained from an actual field survey conducted by Bauer, Davidson & Merchant, Inc. in March of 1996.

All of the survey markers noted on this map were in place in March of 1996.

The bearings shown on this map correspond to the bearing of S-20°31'00"E for the centerline of Linworth Road, as shown on the said recorded plat of Linworth Village Section One.

BAUER, DAVIDSON & MERCHANT, INC.
Consulting Engineers
ROBERT B. STOVER

PERCY 181 357 525