

556.33'

90°-34'

89°-31'

VERY OLD IRON PINS LOCATED 7"± NORTH OF WOOD CORNER FENCE POST. TOP OF PINS ABOVE GRADE 6"±

PARCEL #1 HARD PROPERTY - TOTAL 6.817 ACRES 0.23 ACRES OF LEGAL HWY. R/W

WALTER KNICK PROPERTY

631.54'

381.54'

55

TRACT OF 0.574 ACRES DEED TO BETHEL METHODIST CHURCH - 1957

PARCEL #2 GARDNER PROPERTY 0.689 ACRES

NEW IRON PIN SET HERE

R/W LINE

60' R/W

BETHEL ROAD

BEARING N 88°-56' W FROM COUNTY ROAD PLANS

557.25'

1387.3 FEET MORE OR LESS TO EAST LINE OF GODOWN RD.


SCALE 1" = 100'

PROPERTY LINE SURVEY OF THE SITE FOR RELOCATION OF BETHEL METHODIST CHURCH

We hereby certify that the above plat was made from an actual survey of the premises

9-29-66

ELGAR BROWN CONSULTING ENGINEER COLUMBUS, OHIO

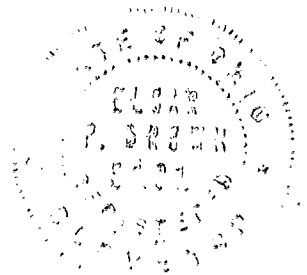

18135 7525
18135 7500

003
0709
1000
074011W
BETHEL ROAD
1271
0270