Myers Surveying Company, Inc.

2740 East Main Street, Columbus 43209 (Bexley), Ohio
614-235-8677 FAX: 614-235-4559

A Boundary Survey prepared for and certified to:
Al Satterwhite and/or Bricker & Eckler, LLP

Legal Description: Situated in Ohio, County of Franklin, City of Columbus, Being 0.815 Acres and part of 0.528 Acres in Section 1, Township 1, Range 19, United States Military Lands

Applicant:

Posted Address: 4663 Kenny Road, Columbus, Ohio

Apparent Encroachments: None.

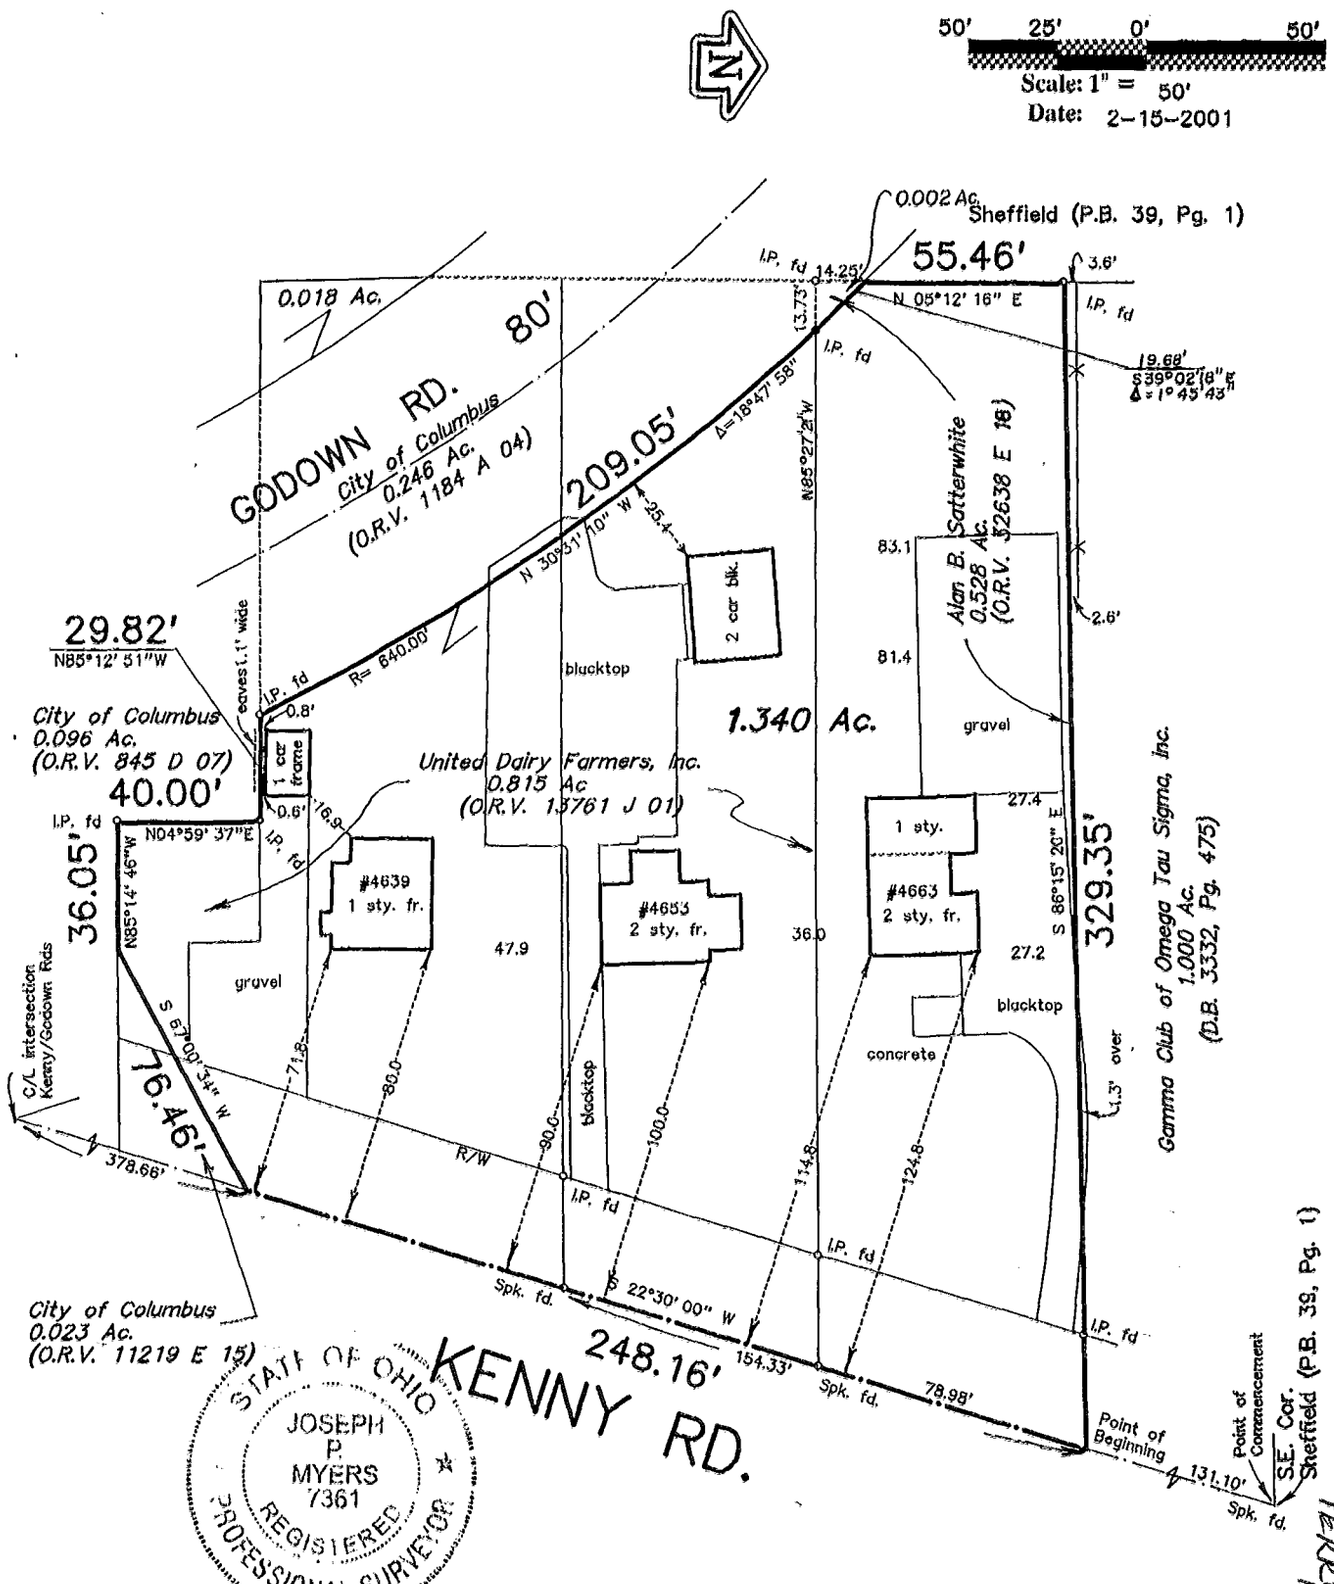

STATE OF OHIO
JOSEPH P. MYERS
7361
REGISTERED
PROFESSIONAL SURVEYOR

We hereby certify that the foregoing Boundary Survey was prepared from actual field measurements in accordance with Chapter 4733-37 Ohio Administrative Code. Iron pins set are 30"x1" O.D. with an orange plastic plug inscribed "P.S. 6579", unless otherwise noted. Basis of bearing is the centerline of Kenny Road held as South 22 degrees 30 minute West as per ORV 32638 E18

Myers Surveying Co., Inc.
By Joseph P. Myers
Professional Surveyor

Myers Order No. - 7-01/24/01	Rec.	Field	DWG	Ltr.	Ck.