





STULTS and ASSOCIATES, INC.
ENGINEERS • PLANNERS • SURVEYORS

585 SUNBURY ROAD (U.S. 36), DELAWARE, OHIO 43015-9795
 DELAWARE: (614) 363-6792 COLUMBUS: (614) 548-4707
 MARION: (614) 387-9180 FAX: (614) 436-5238

PLAT OF SURVEY FOR WILLIAM D. CARIDAS & DOROTHA K. CARIDAS
 LOT 656 FOREST PARK EAST SECTION 8 ADDITION, P.B. 40, Pgs. 81-83
 LOT 622 FOREST PARK EAST SECTION 5 ADDITION, P.B. 40, Pg. 9
 CITY OF COLUMBUS, FRANKLIN COUNTY, OHIO

OWNERS:
 WILLIAM D. CARIDAS AND
 DOROTHA K. CARIDAS
 D.V. 3642, PG. 836

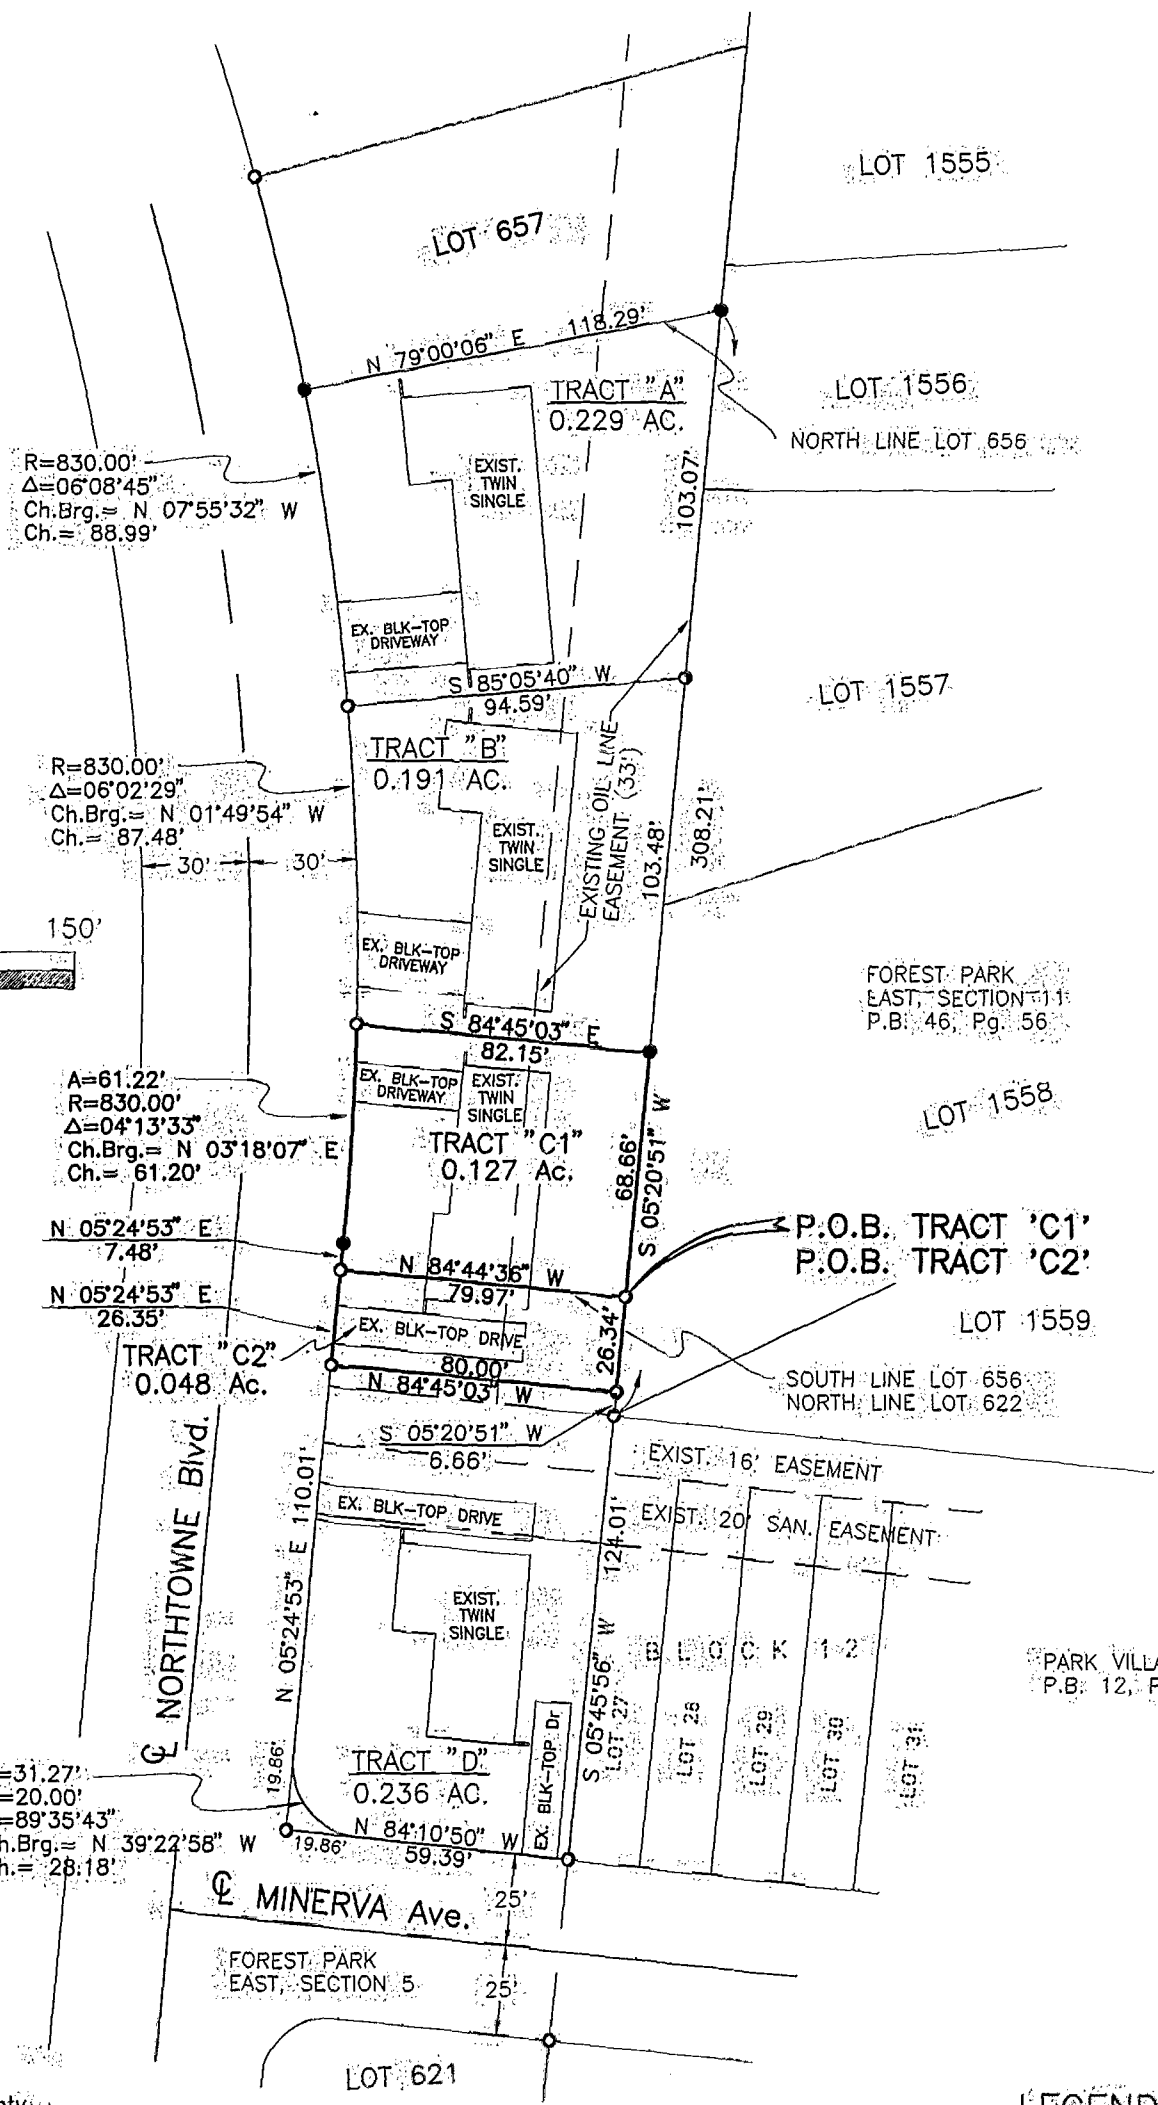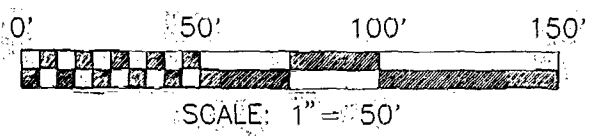

BASIS OF BEARINGS:
 Bearings are based on the bearings as shown on the plat of Forest Park East, Section 8, as platted in Plat Book 40, page 81-83, Franklin County Recorder's Office, AS BEING
 S 05° 20' 51" W

Note: This plat is not intended to show all easements affecting this tract. Easements, if any, contained in a title policy report will be shown upon request when accompanied by a copy of said report.

We hereby certify that the above plat was prepared from an actual survey and to the best of our knowledge is correct.

David B. McCoy
 DAVID B. McCOY
 Registered Surveyor No. 7632
 DATE: 8/25/99

LEGEND
 ● = IRON PIN FOUND

File No. 93-411-B