

184107575

MYERS SURVEYING CO.

2740 East Main Street, Columbus 9 (Bexley), Ohio

PART OF LOT 10

JORDAN'S SUB.

BLENDON TWP.


FOR

M. 199

MARKIN BROTHERS, INC.

P.B. 17 Page 288
Scale 1"=40'

Franklin Co. Rec. Office
1-17-70

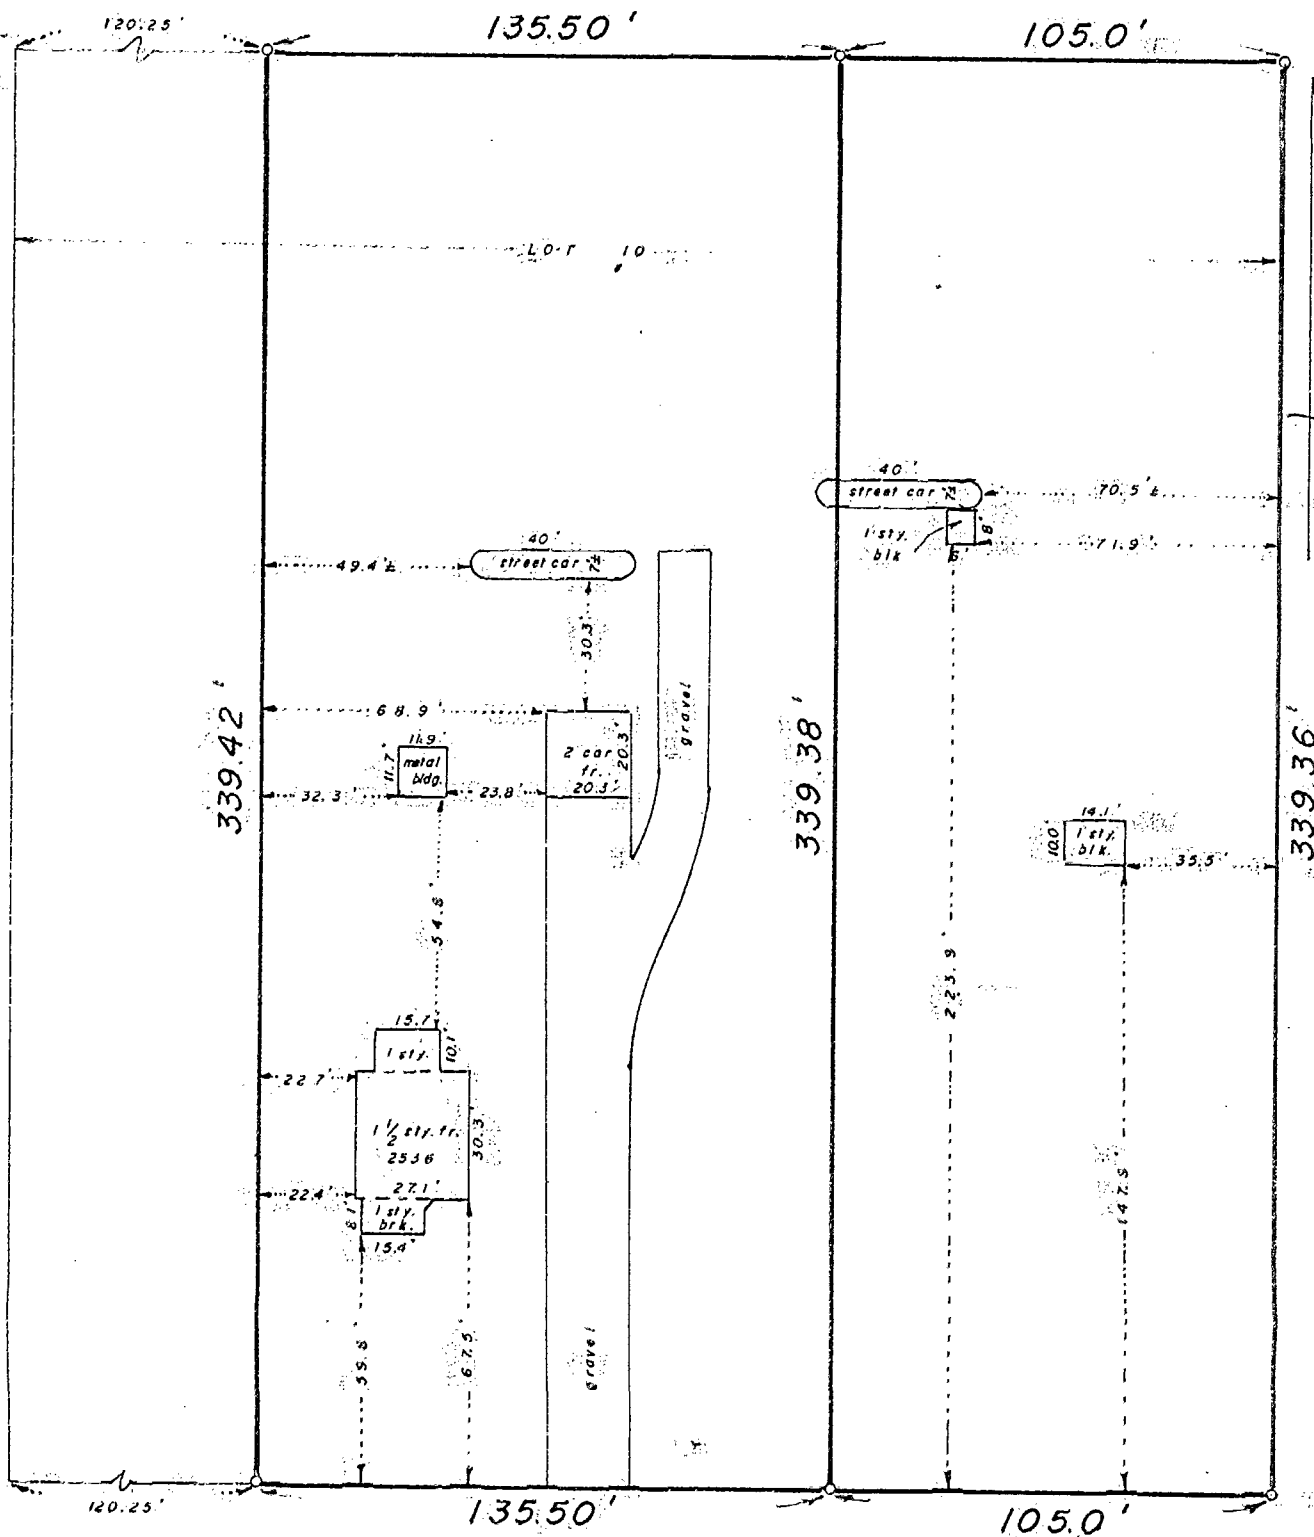

JORDAN ROAD 44.5'

We hereby certify that the foregoing plat was prepared from an actual survey of the premises. No side line of principal building is less than dimension shown. Iron pins not set unless indicated thus -0-.

MYERS SURVEYING CO.

BY *W. Myers*
Registered Surveyor

b67-111