



PLAT OF LOT SPLIT  
 LOT 397, CLEVELAND HEIGHTS SECTION 3  
 CITY OF COLUMBUS, FRANKLIN COUNTY, OHIO

EXHIBIT  
 D

84-07525

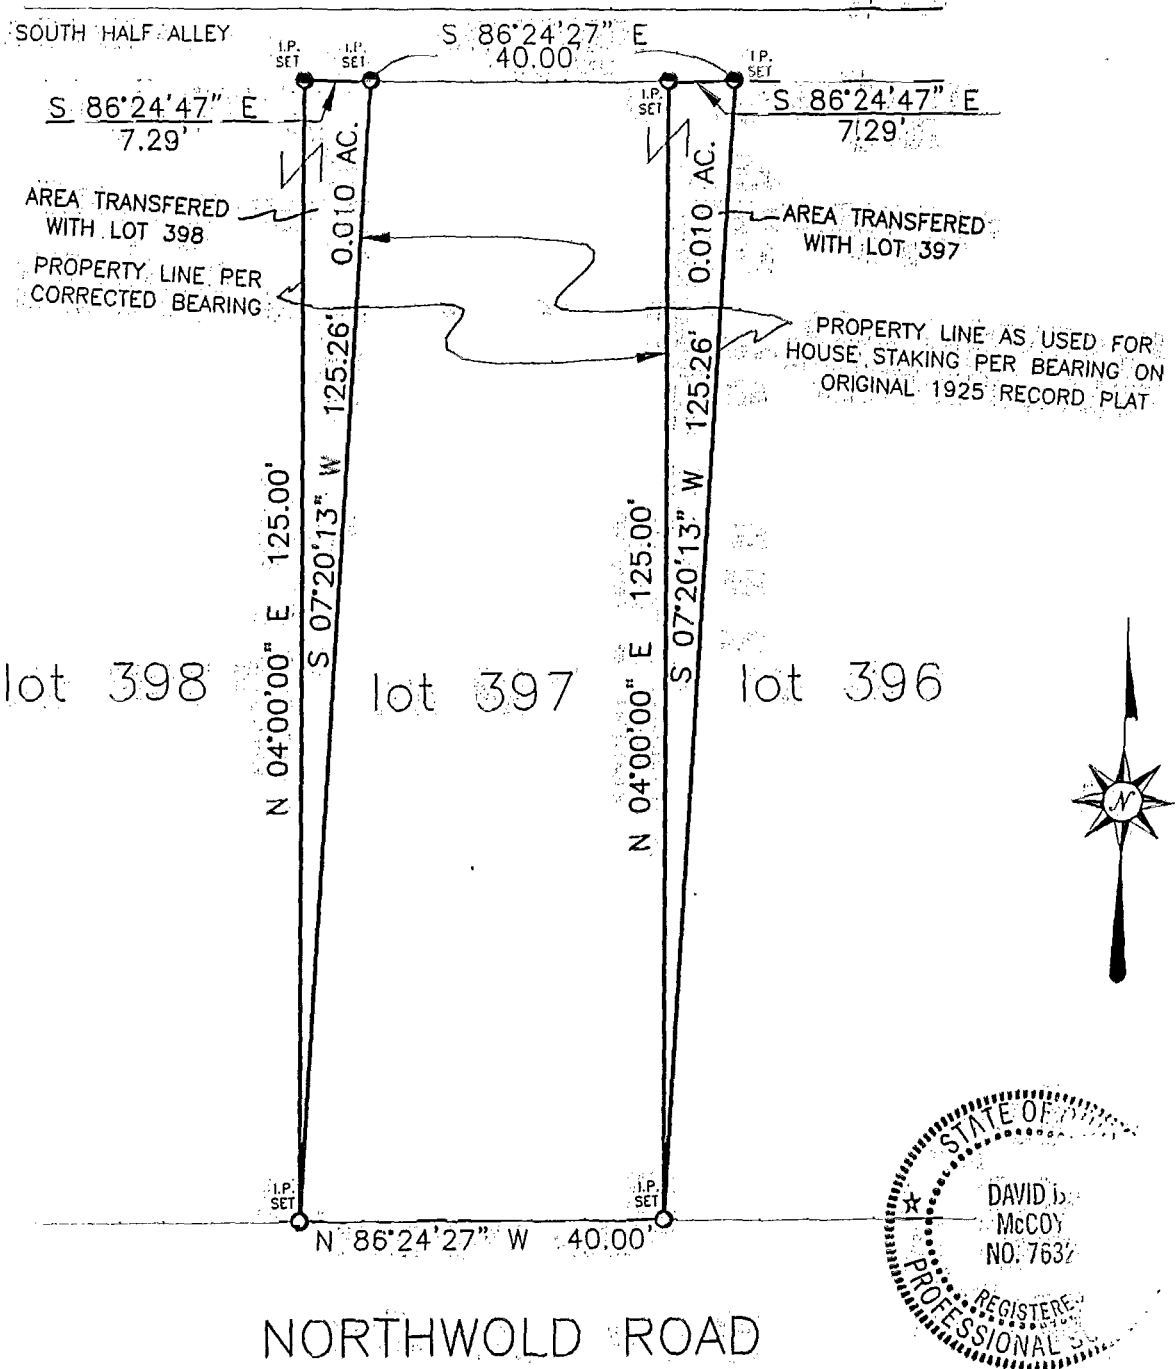

STATE OF OHIO  
 DAVID B. MCCOY  
 NO. 7632  
 REGISTERED PROFESSIONAL SURVEYOR

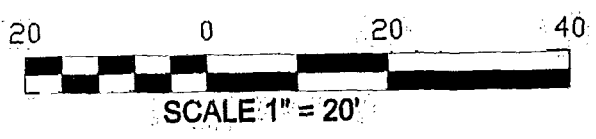

This plat is not intended to create any additional building sites, it is for the purpose of correcting property line due to an error in the bearings on the original recorded plat of Cleveland Heights No. 3 of record in Plat Book 18, page 12.

Bearings are based on the bearing for Cleveland Avenue (N 04°00'00" E) as contained on the plat of Cleveland Heights No. 3, as recorded in Plat book 18, page 12.

5750 Chandler Court  
 Westerville, OH 43082  
 E-Mail: hoyssinc@aol.com  
 Phone (614) 895-1922  
 Survey Fax (614) 895-1949  
 Construction Fax (614) 895-9549

**HOY**  
 SURVEYING  
 SERVICES, INC.

We hereby certify that the above plat was prepared from an actual field survey and to the best of our knowledge and belief is correct. All dimensions along arcs are chord distances.

HOY SURVEYING SERVICES, INC.  
 David B. McCoy  
 Registered Professional Surveyor No. 7632  
 Date 12/20/00

Order No. 25000-2000

M-159  
 BLENDON TRD