

MYERS SURVEYING Co.

2740 East Main Street, Columbus 43209 (Bexley), Ohio

Survey of 0.370 Acres, Part of an original 14.51 Acre tract (D.B. 994, Pg. 420) in Section 1, Township 1, Range 19, United States Military Lands, City of Upper Arlington, Franklin Co., Ohio.


068D

0857430

ESTATE OF RICHARD E. ROGERS


P.B. Page
Scale 1" = 25'

Franklin Co. Rec. Office
8-07-84

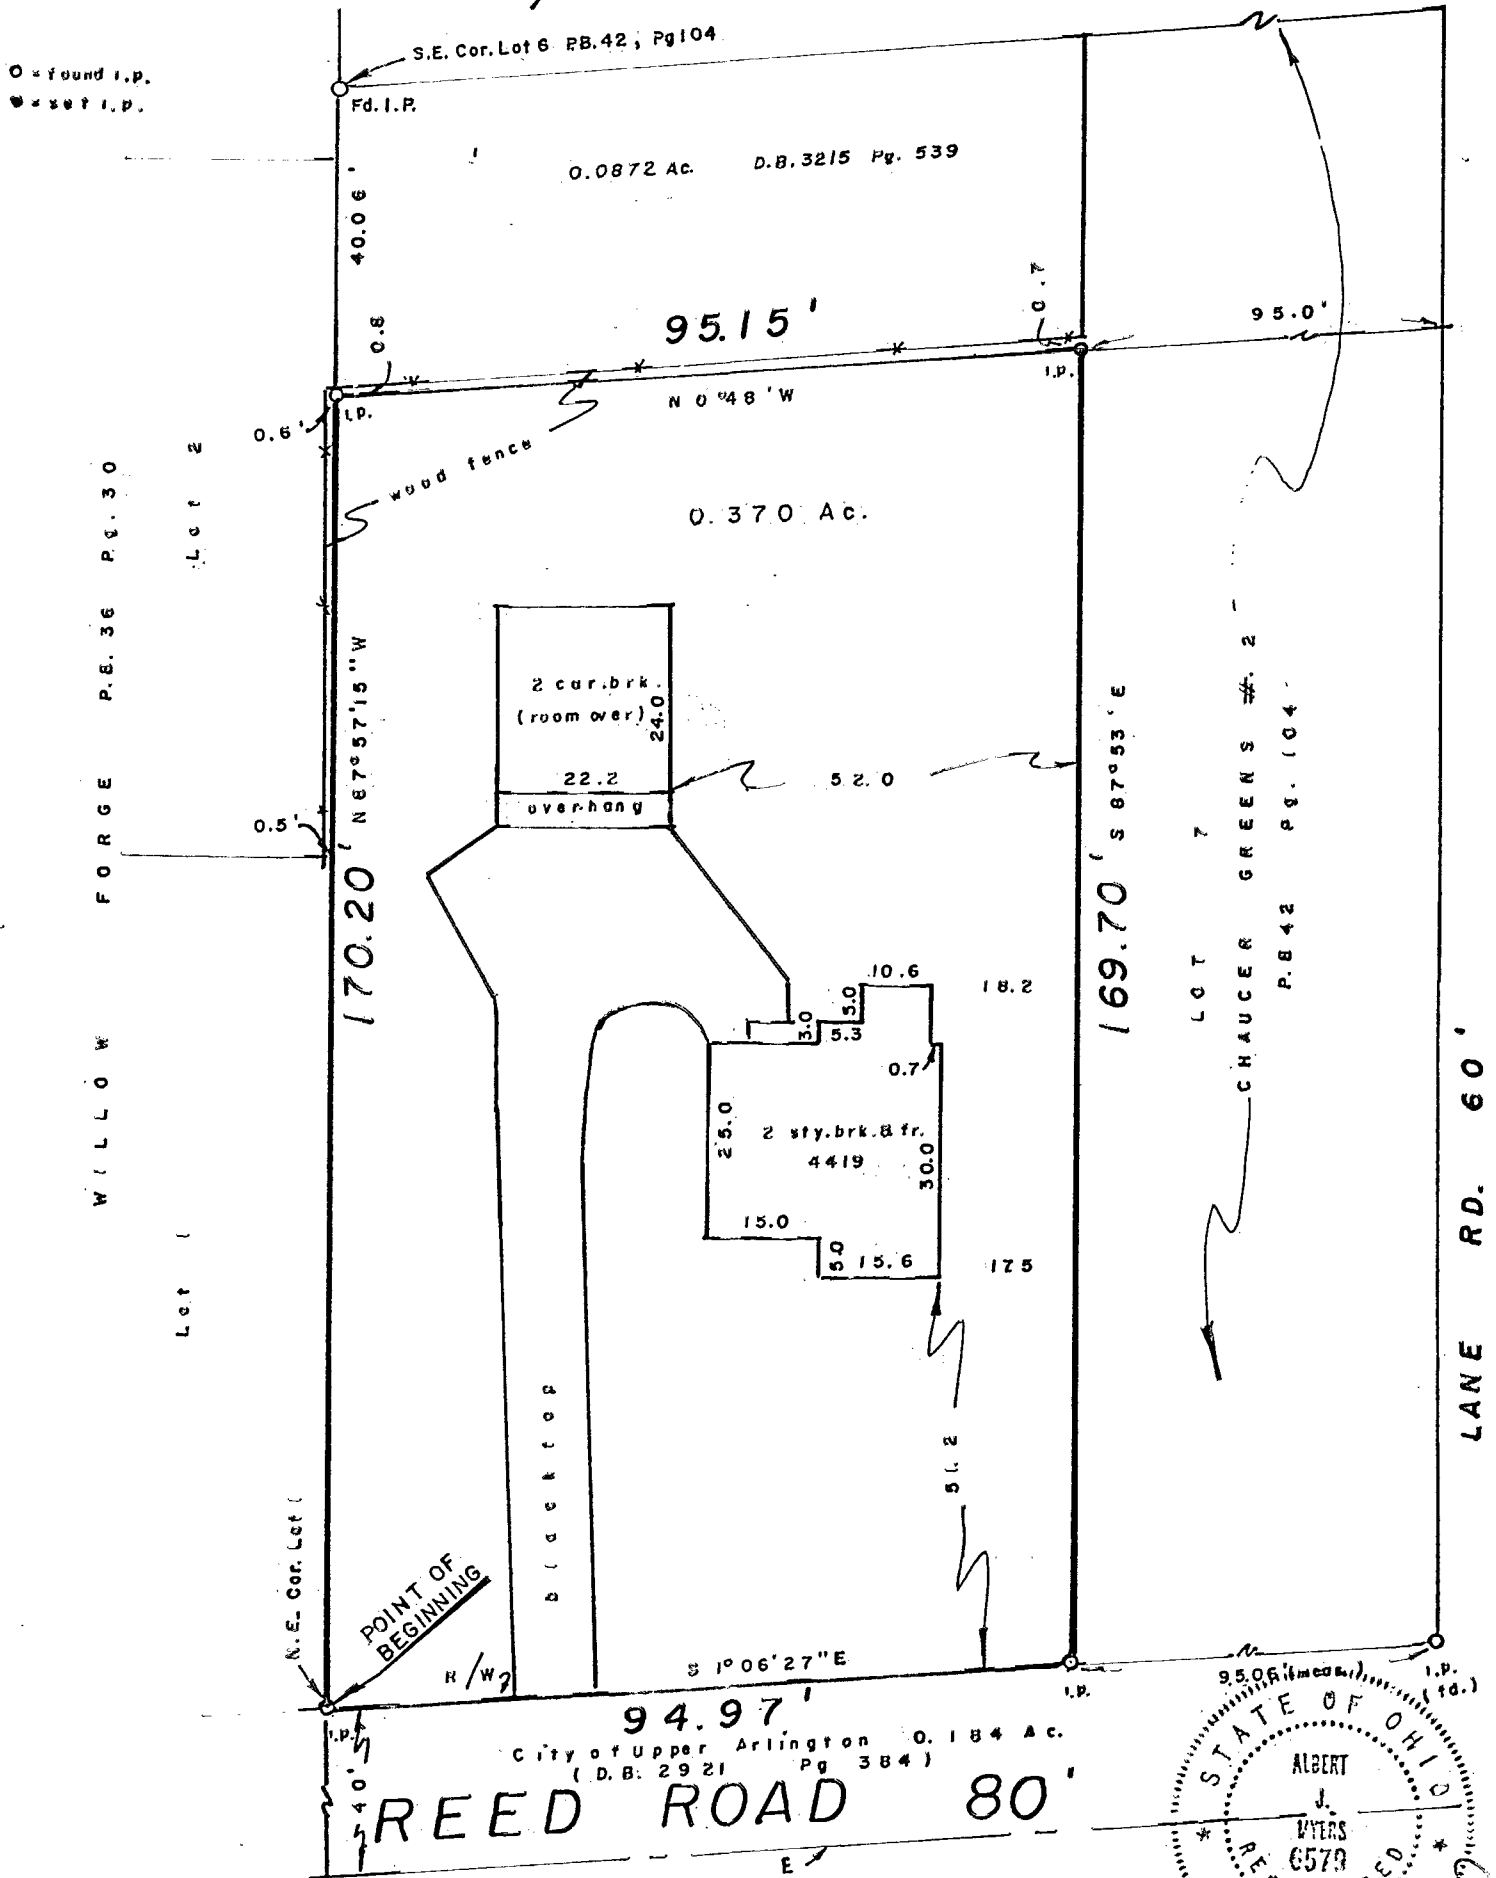

I hereby certify the foregoing plat was prepared from a survey of the premises in July, 1984 and said plat is correct to the best of my knowledge. Basis of bearings is the centerline of Reed Rd. per P.B. 42, Pg. 104. Iron pipes set are 30" X 1" O.D. with plastic cap inscribed "P.S. 3352".

MYERS SURVEYING CO.
BY Albert Myers
Registered Surveyor

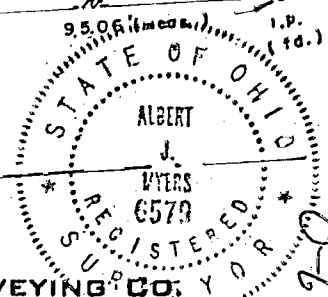

068D TWO