

181101475

MILITARY

& W. 20' OF LOT NO. 8, KNOLLS WEST, SEC. NO. 1
COLUMBUS, OHIO

CERTIFIED TO LOUISVILLE TITLE OF CENTRAL OHIO, INC.
AND/OR THE KISSELL CO.


SCALE: 1" = 30'

DATE: OCT. 6, 1972

FRANKLIN COUNTY RECORDER'S OFFICE

PLAT BOOK 38, PAGE 22

DEED BOOK 3160, PAGE 451

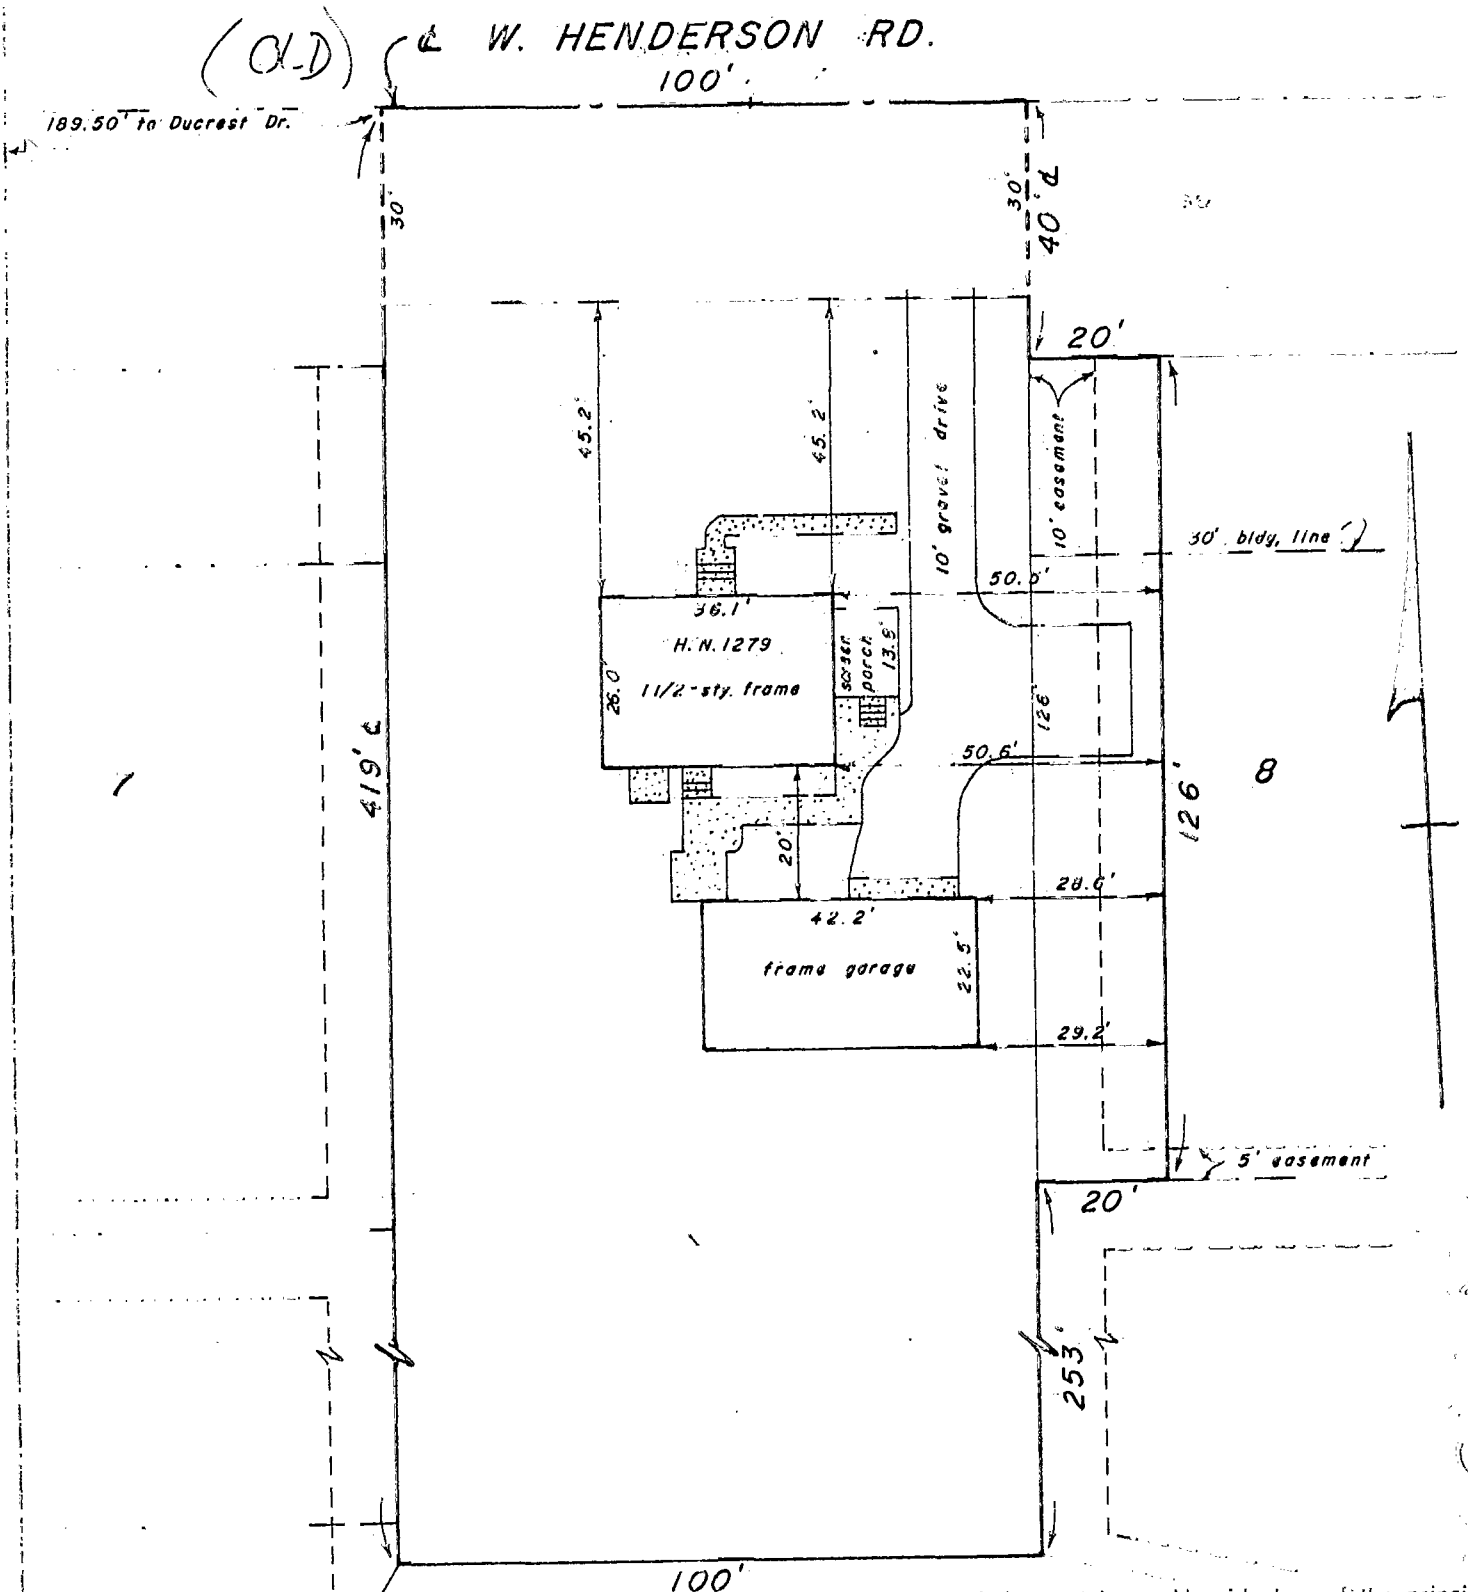

We hereby certify that the foregoing plat was prepared from an actual survey of the premises. No side line of the principal building is less than dimensions shown. Iron pins are not set unless shown thus: . For mortgage loan and title insurance purposes only.

C. F. BIRD & R. J. BULL, LTD.
6113 LINWORTH RD., WORTHINGTON, O

By *Richard J. Bull*
Registered Surveyor No. 4123

CASE NO

CORNETT

SV 5831