

18235 1450
18235 1425

MYERS SURVEYING CO.

2740 East Main Street, Columbus 43209 (Bexley), Ohio



Being 0.076 Acres, Part of Lots 30 and 31, Glenmont Subdivision, Plat Book 8, Page 18-B, Columbus, Franklin County, Ohio.

Wilma Wyckoff and/or Mary R. Oakes and/or Nadine Sellard

P.B. 8 Page 18-B


Franklin Co. Rec. Office

10 · 15 · '90

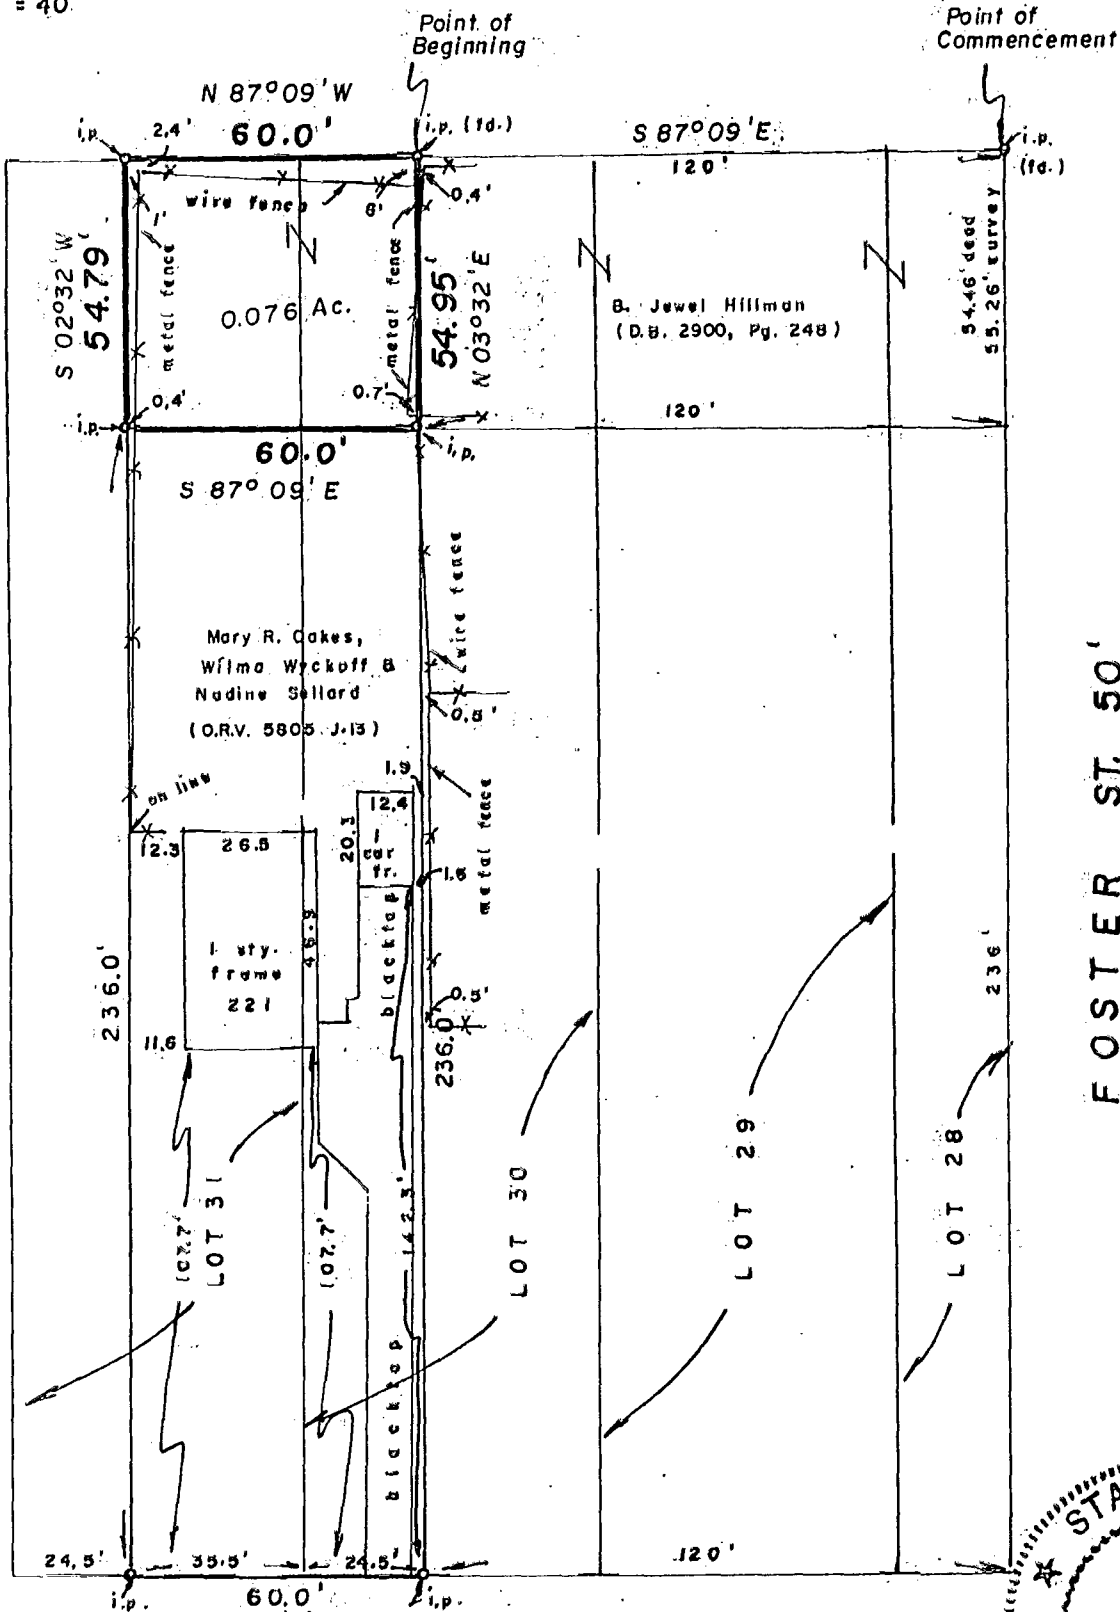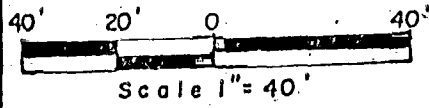

GLENMONT RD. 60'

We hereby certify that the foregoing plat was prepared from an actual survey of the premises. Iron pins set are 30" x 1" O.D. with orange plastic caps inscribed "P.S. 6579". Basis of bearings is south line of Glenmont Road as scaled from City of Columbus plats.

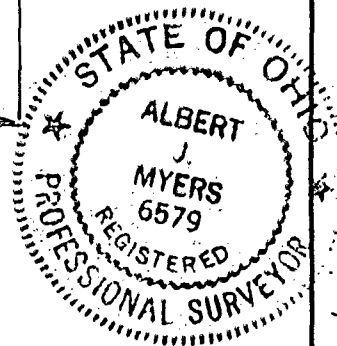

MYERS SURVEYING CO.

BY *Albert J. Myers*
Registered Surveyor