


Survey Book
No. 1

Page 278

4/14

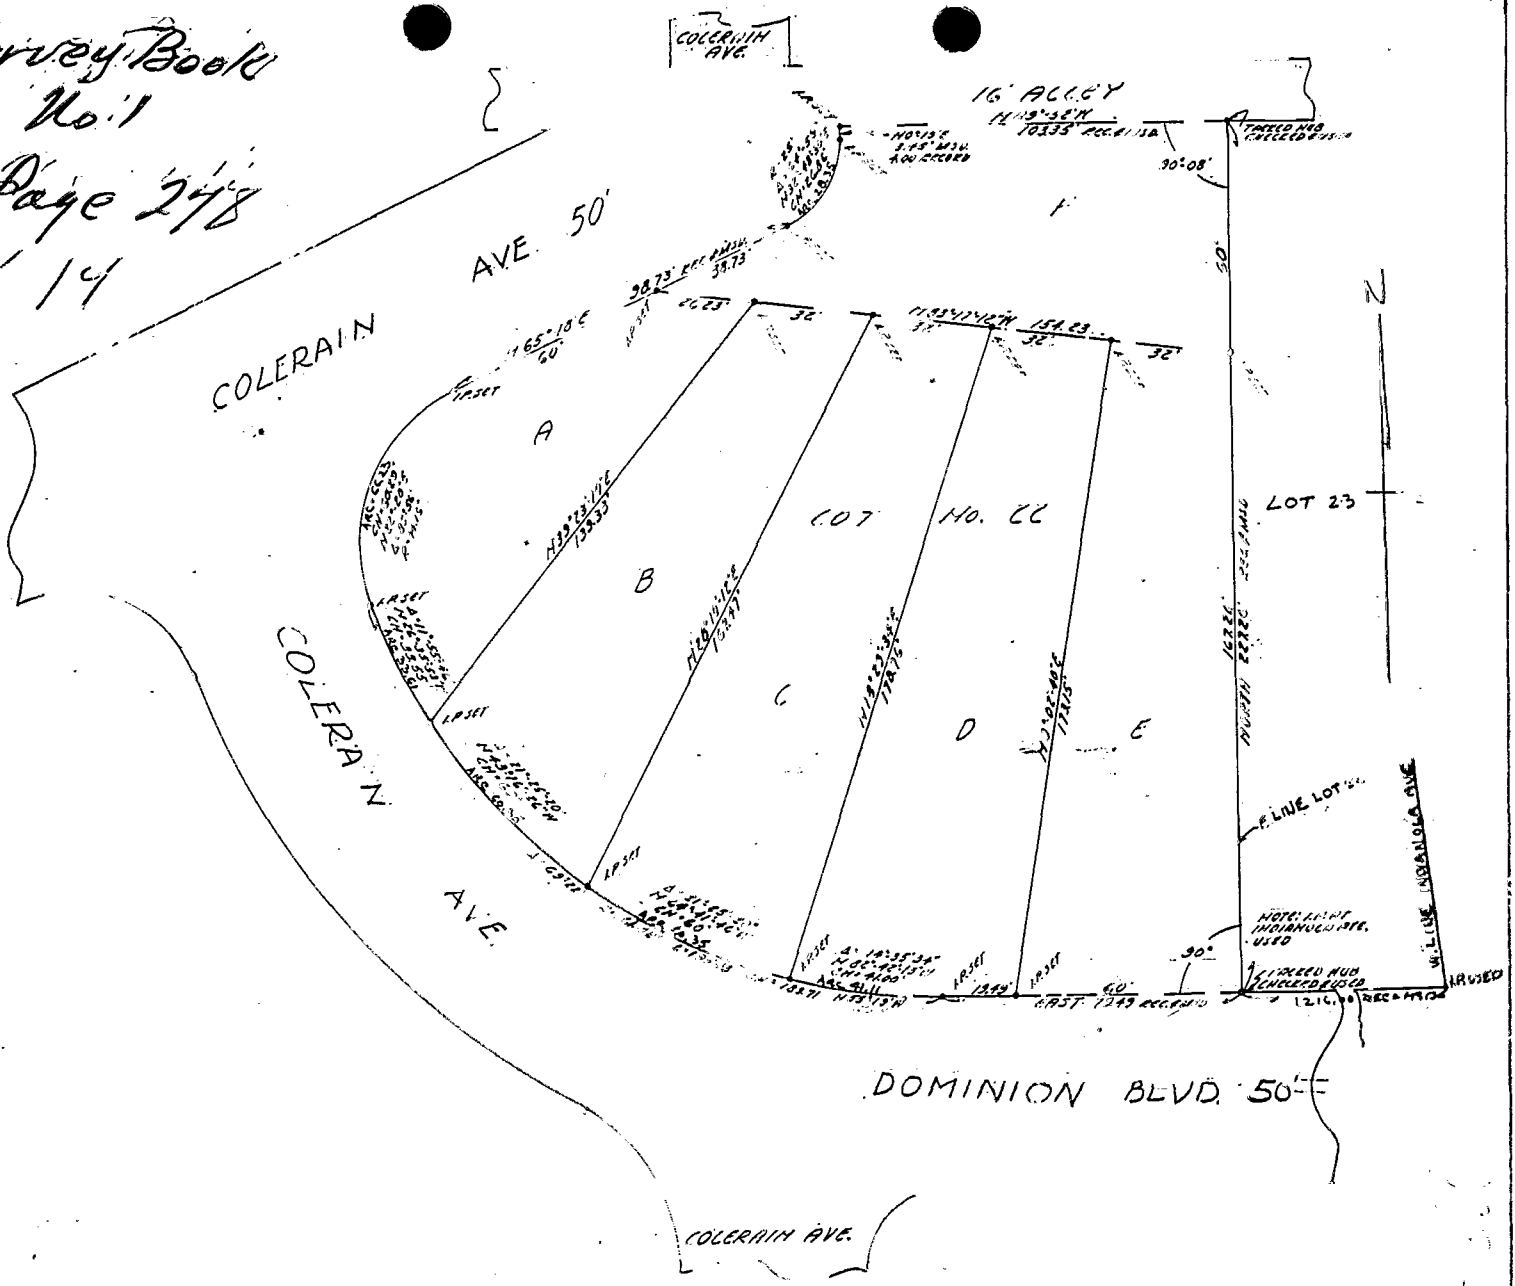

SURVEY FOR
J. A. TROUTMAN

OF PARTS OF LOT NO. 22 IN DOMINION HEIGHTS (VOL. 70, PG. 57)
SUBDIVISION AS SHOWN HEREON.
I DO HEREBY CERTIFY THIS SURVEY TO BE CORRECT

SCALE 1" = 20'

[Signature]

JAN. 13 1949

18935 1500

DWG # 3505
322