

OLENTANGY RIVER RD

81357425

H. S. WOLLETT ESTATES

RR 23 PG. 15


2 3 4 5 6

"X" CUT IN CONC.
BASE OF FENCE POST
106.25'


COLUMBUS

0-13-B

70-500

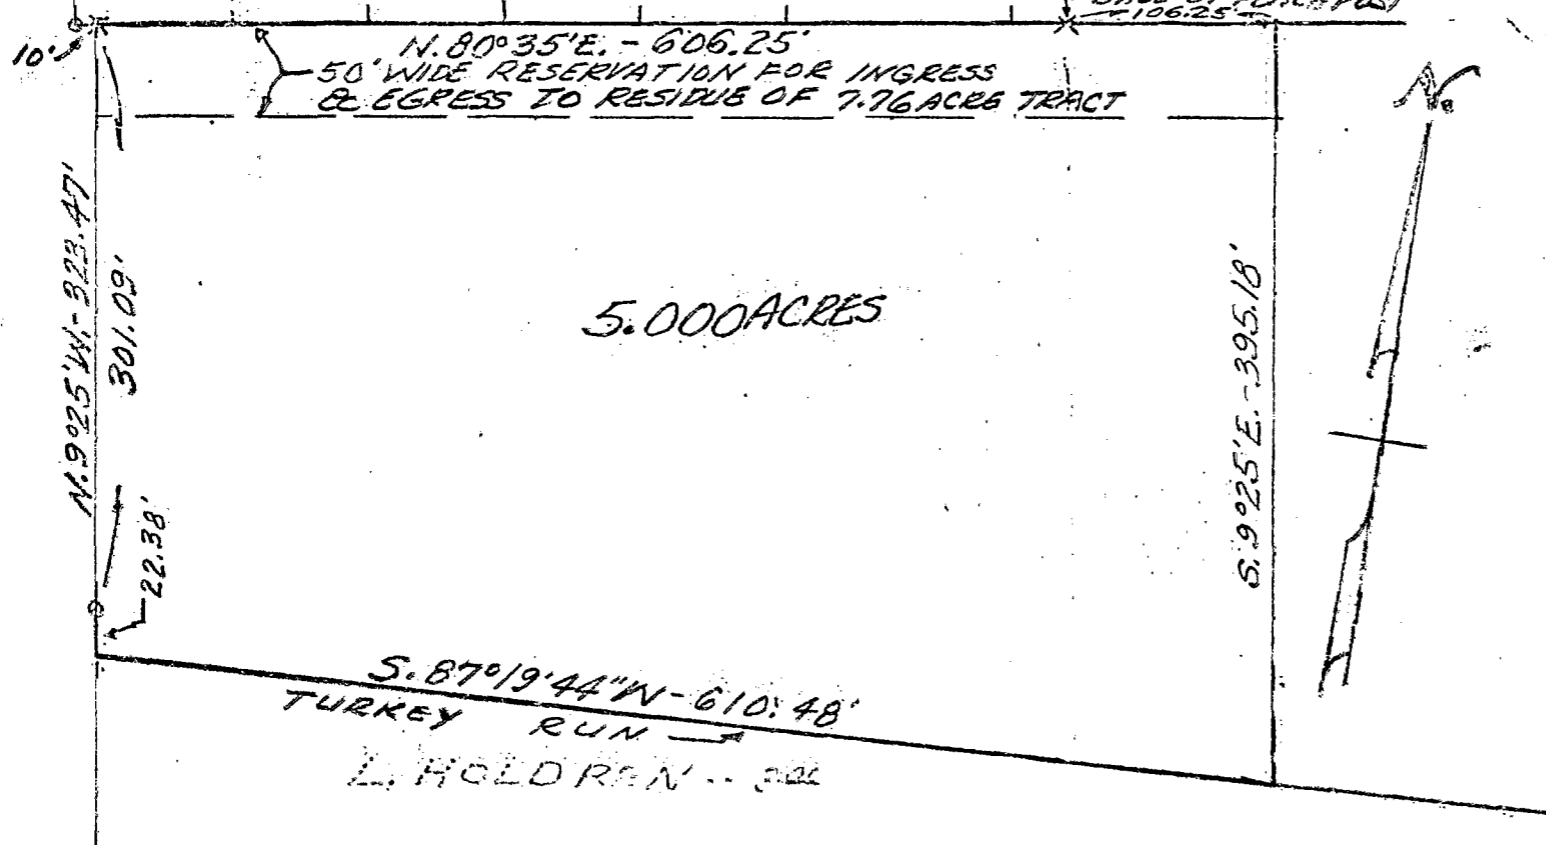

~ LOCATION MAP ~

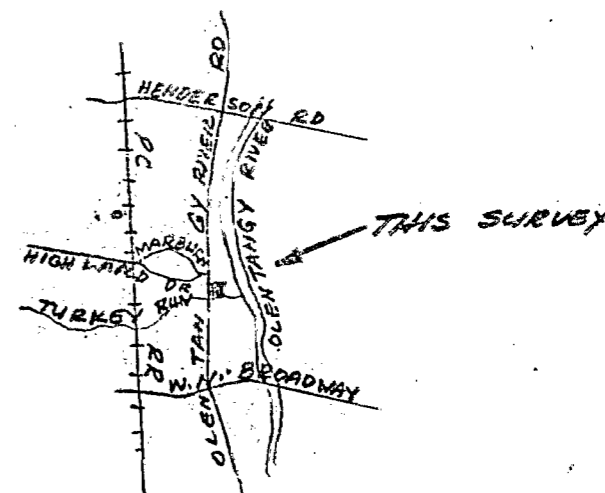

~ PLAT SHOWING ~
SURVEY OF 5.000 ACRE TRACT IN SEC. 2
T. 1 N., R. 18 W., U. S. M. LANDS, CITY
OF COLUMBUS, OHIO

~ SURVEYED FOR ~
H. S. WOLLETT & CO.
465 ANNADALE DRIVE
COLUMBUS, OHIO 43214

MAY 7 1970 - 105290

O = IRON PIPE FOUND
* = IRON PIPE SET
SCALE: 1" = 100'



Robert J. Patridge
PROFESSIONAL SURVEYOR #4338
4466 DUBLIN ROAD
COLUMBUS, OHIO 43214

3400 420 102 041 E OLENTANGY RIVER RD. 1970 0120 03