


18285 7425

M-158-E

PLAT OF #690 & #692 MOON ROAD

NORTHEDGE MANOR

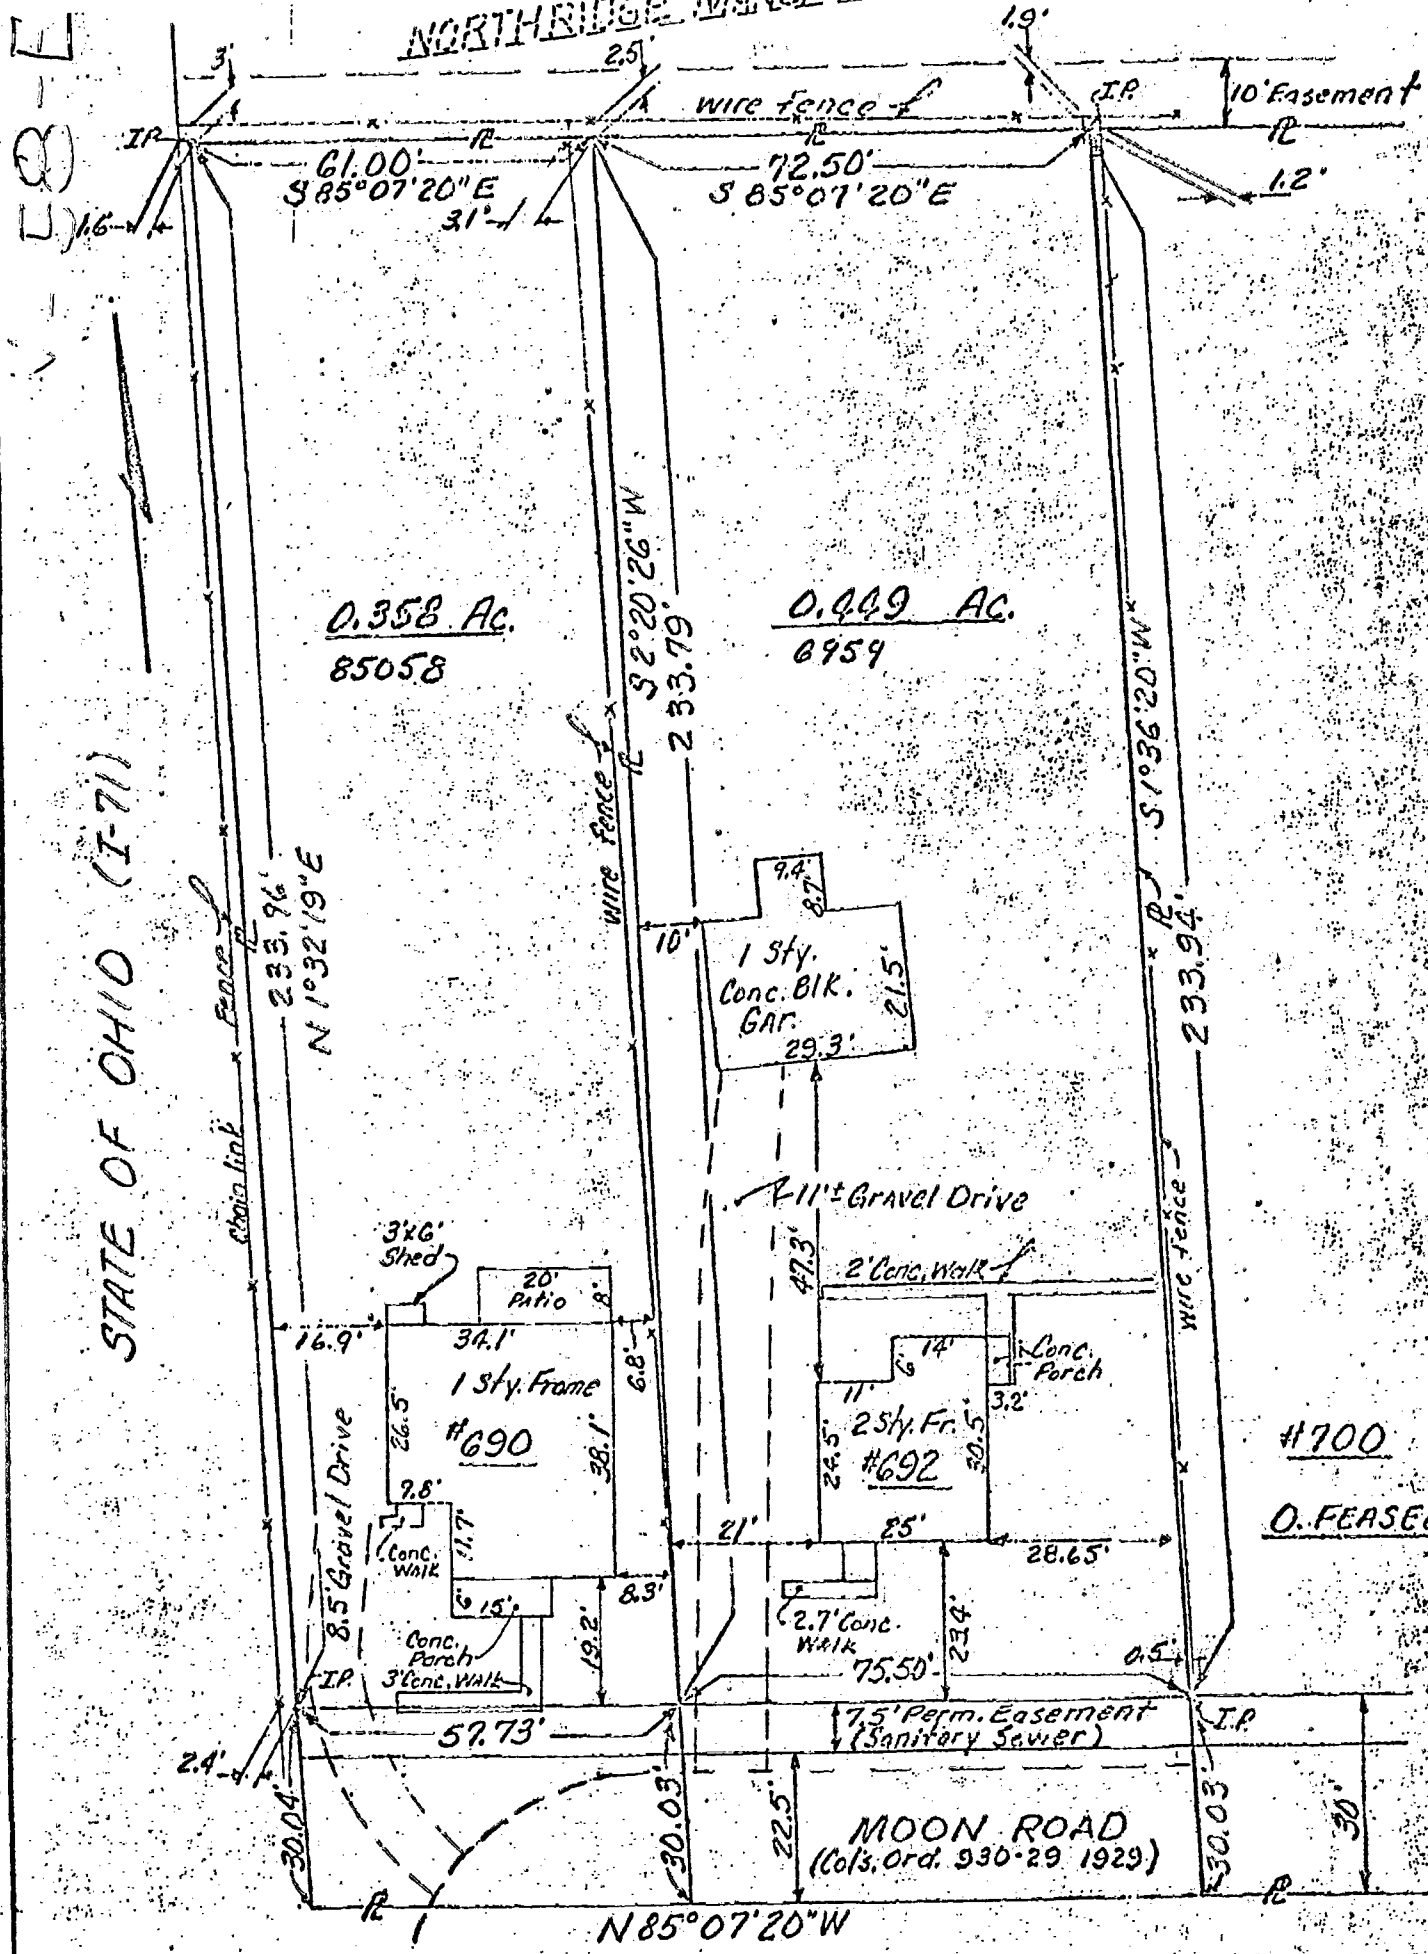

STATE OF OHIO (I-71)

1"=30'

I hereby certify that the above drawing is based on an actual survey of the premises.

Michael J. Re...

MAY 20, 1972
Columbus, Ohio

M-158-E