83 60745

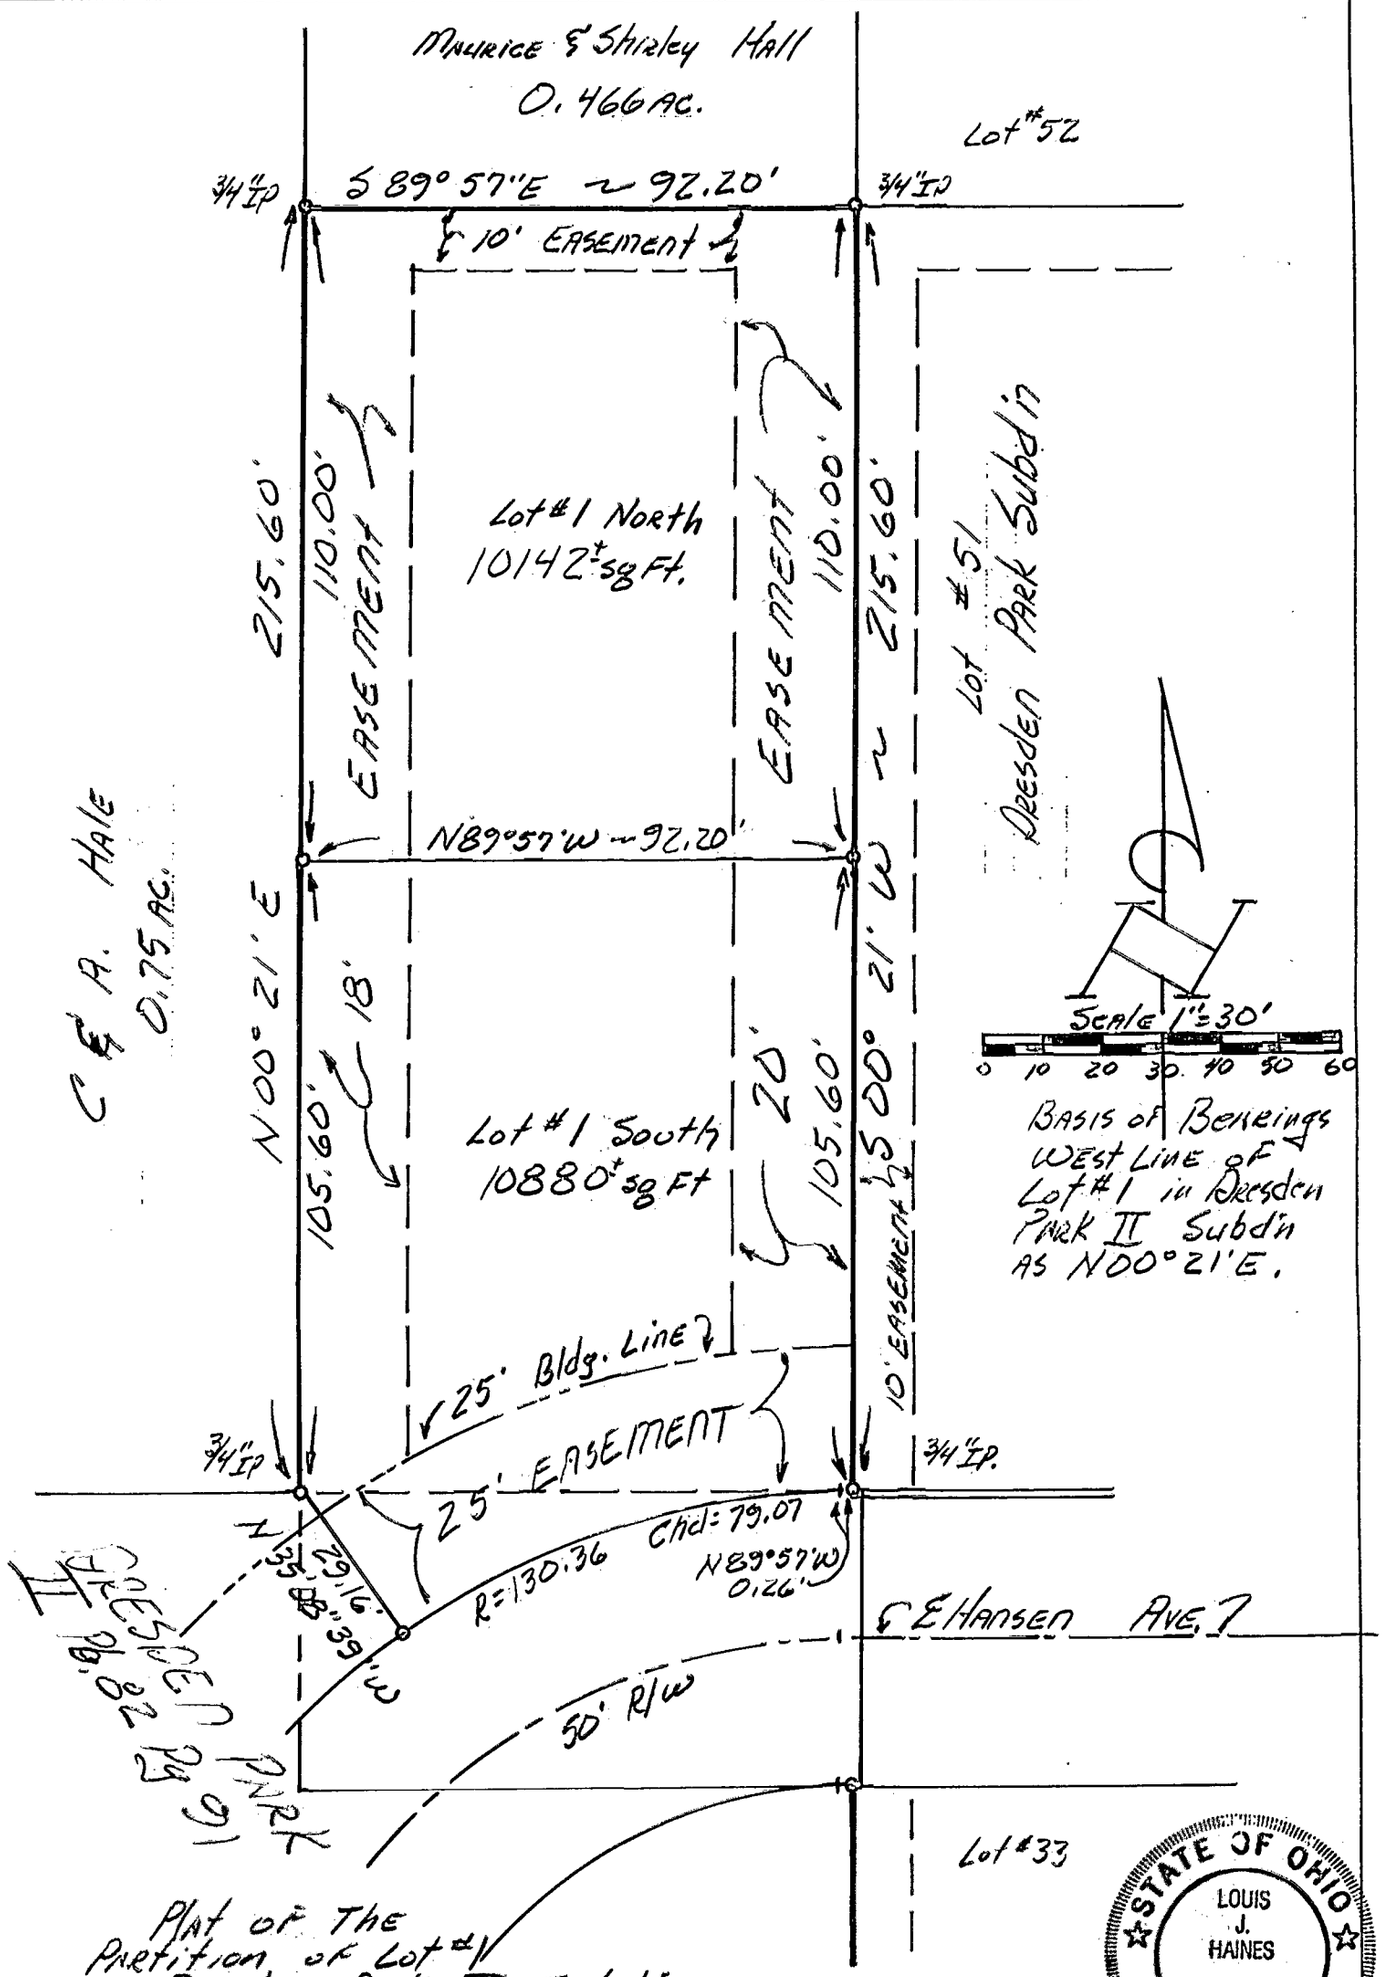

Plat of The Partition of Lot #1 in Dresden Park II Subd'n City of Columbus, Franklin Co. Ohio: FCR

Joe Gantnor

STATE OF OHIO
LOUIS J. HAINES
#7205
REGISTERED
PROFESSIONAL SURVEYOR

HAINES SURVEYORS
354 Kessler Street
Groveport, Ohio 43125
Phone: 837-2181

I hereby certify that the plat shown hereon was performed from an actual field survey, under my supervision and that said plat correctly represents said survey.

DATE 12-15-95 SIGNED [signature]