

NORTHLAND SURVEYING COMPANY


GDE BAH 494-90
 DRN. CK. ORDER NO.

614-895-1522

182107350

CERTIFIED TO A.R.T.A. NORTH COUNTY OF FRANKLIN
 LENDER HELPBRINGER MORTG. P.B. 16 PG. 13 D.B. _____ PG. _____
 SCALE 1" = 20' DATE FEB. 20, 1990 BUYER WARD
 REV. 3/12/90

LOT NO. 29
 MANHATTAN PARK
 COLUMBUS, OHIO

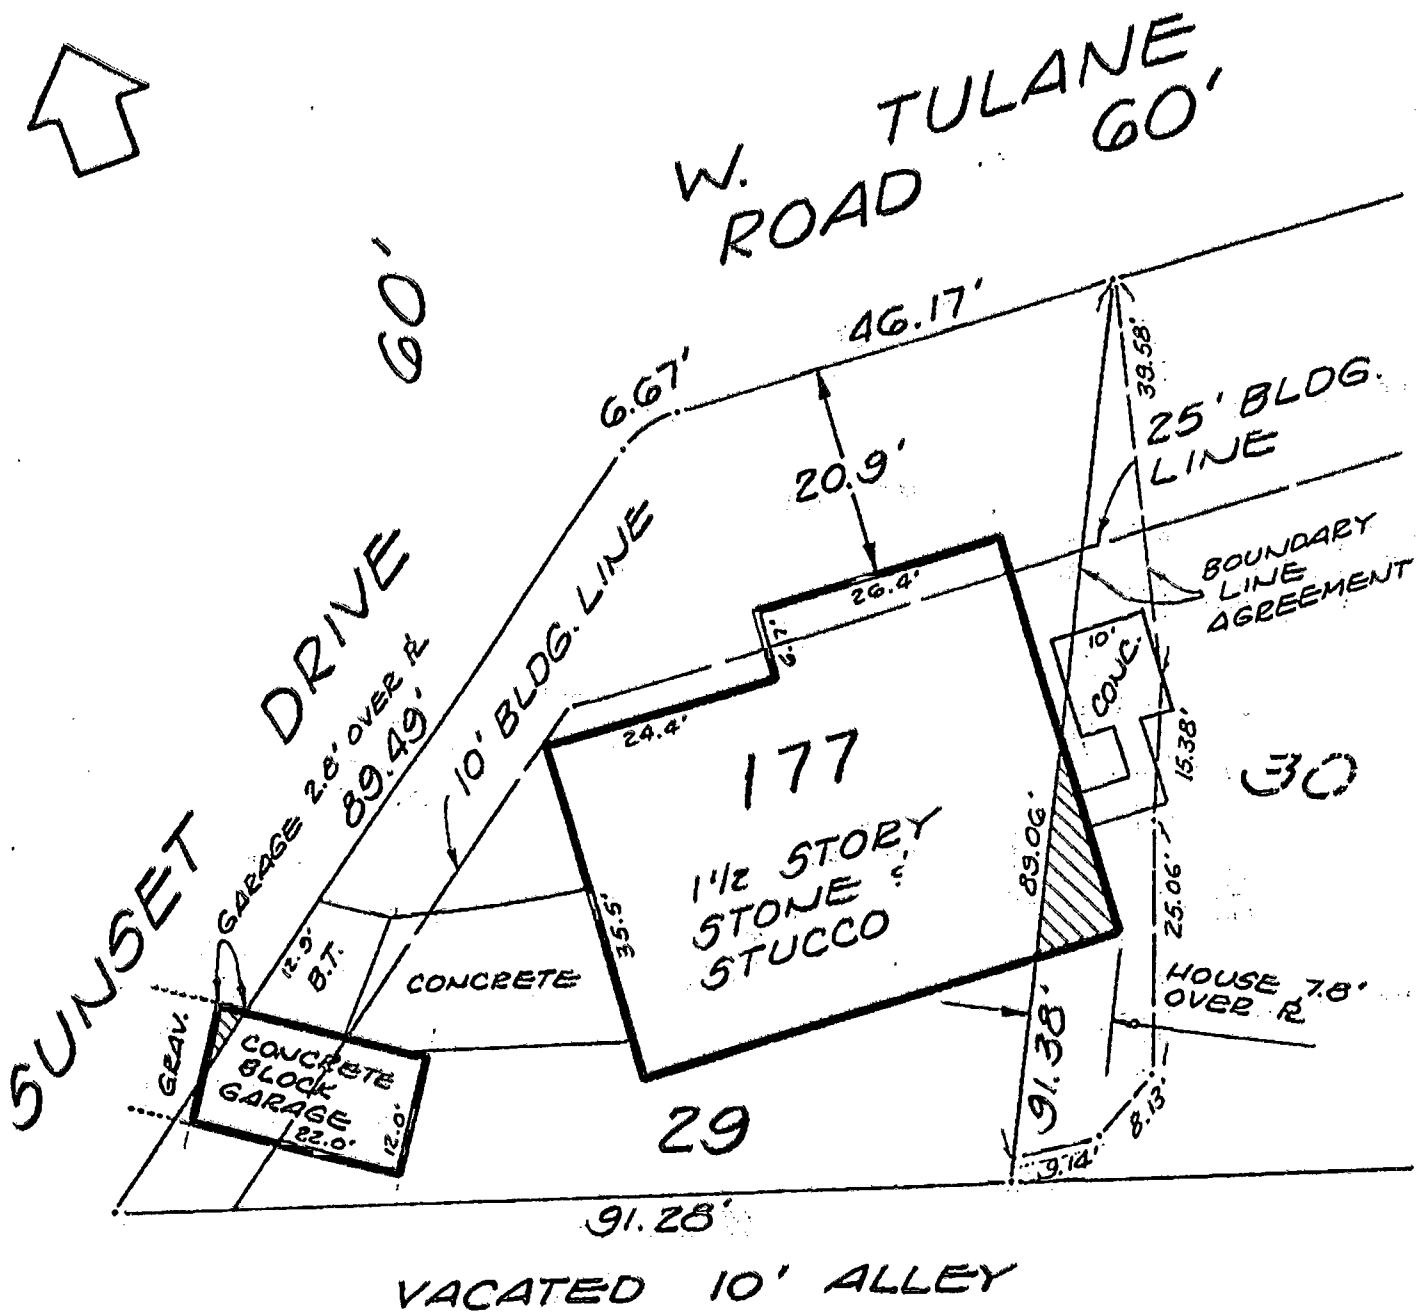

We hereby certify that the foregoing plat was prepared from an actual survey of the premises and correctly shows the location of the building or buildings including any drives. This plat is prepared for mortgage loan and title purposes only and is not to be construed as having been prepared for the owner or for the use of the owner for any purpose. Subject to all rights-of-way, easements and restrictions, if any, of previous record.

Northland Surveying Company

6040 CLEVELAND AVENUE
 COLUMBUS, OHIO 43231
 GARY L. ERLBACH
 5519
 REGISTERED SURVEYOR