


**SURVEY OF ACREAGE PARCEL**  
 LOCATED IN  
 QTR TWP 3 TWP 1 RNG 18 USML  
 CITY OF COLUMBUS, FRANKLIN COUNTY, OHIO

SCALE 1" = 200'

NOVEMBER 10, 2000

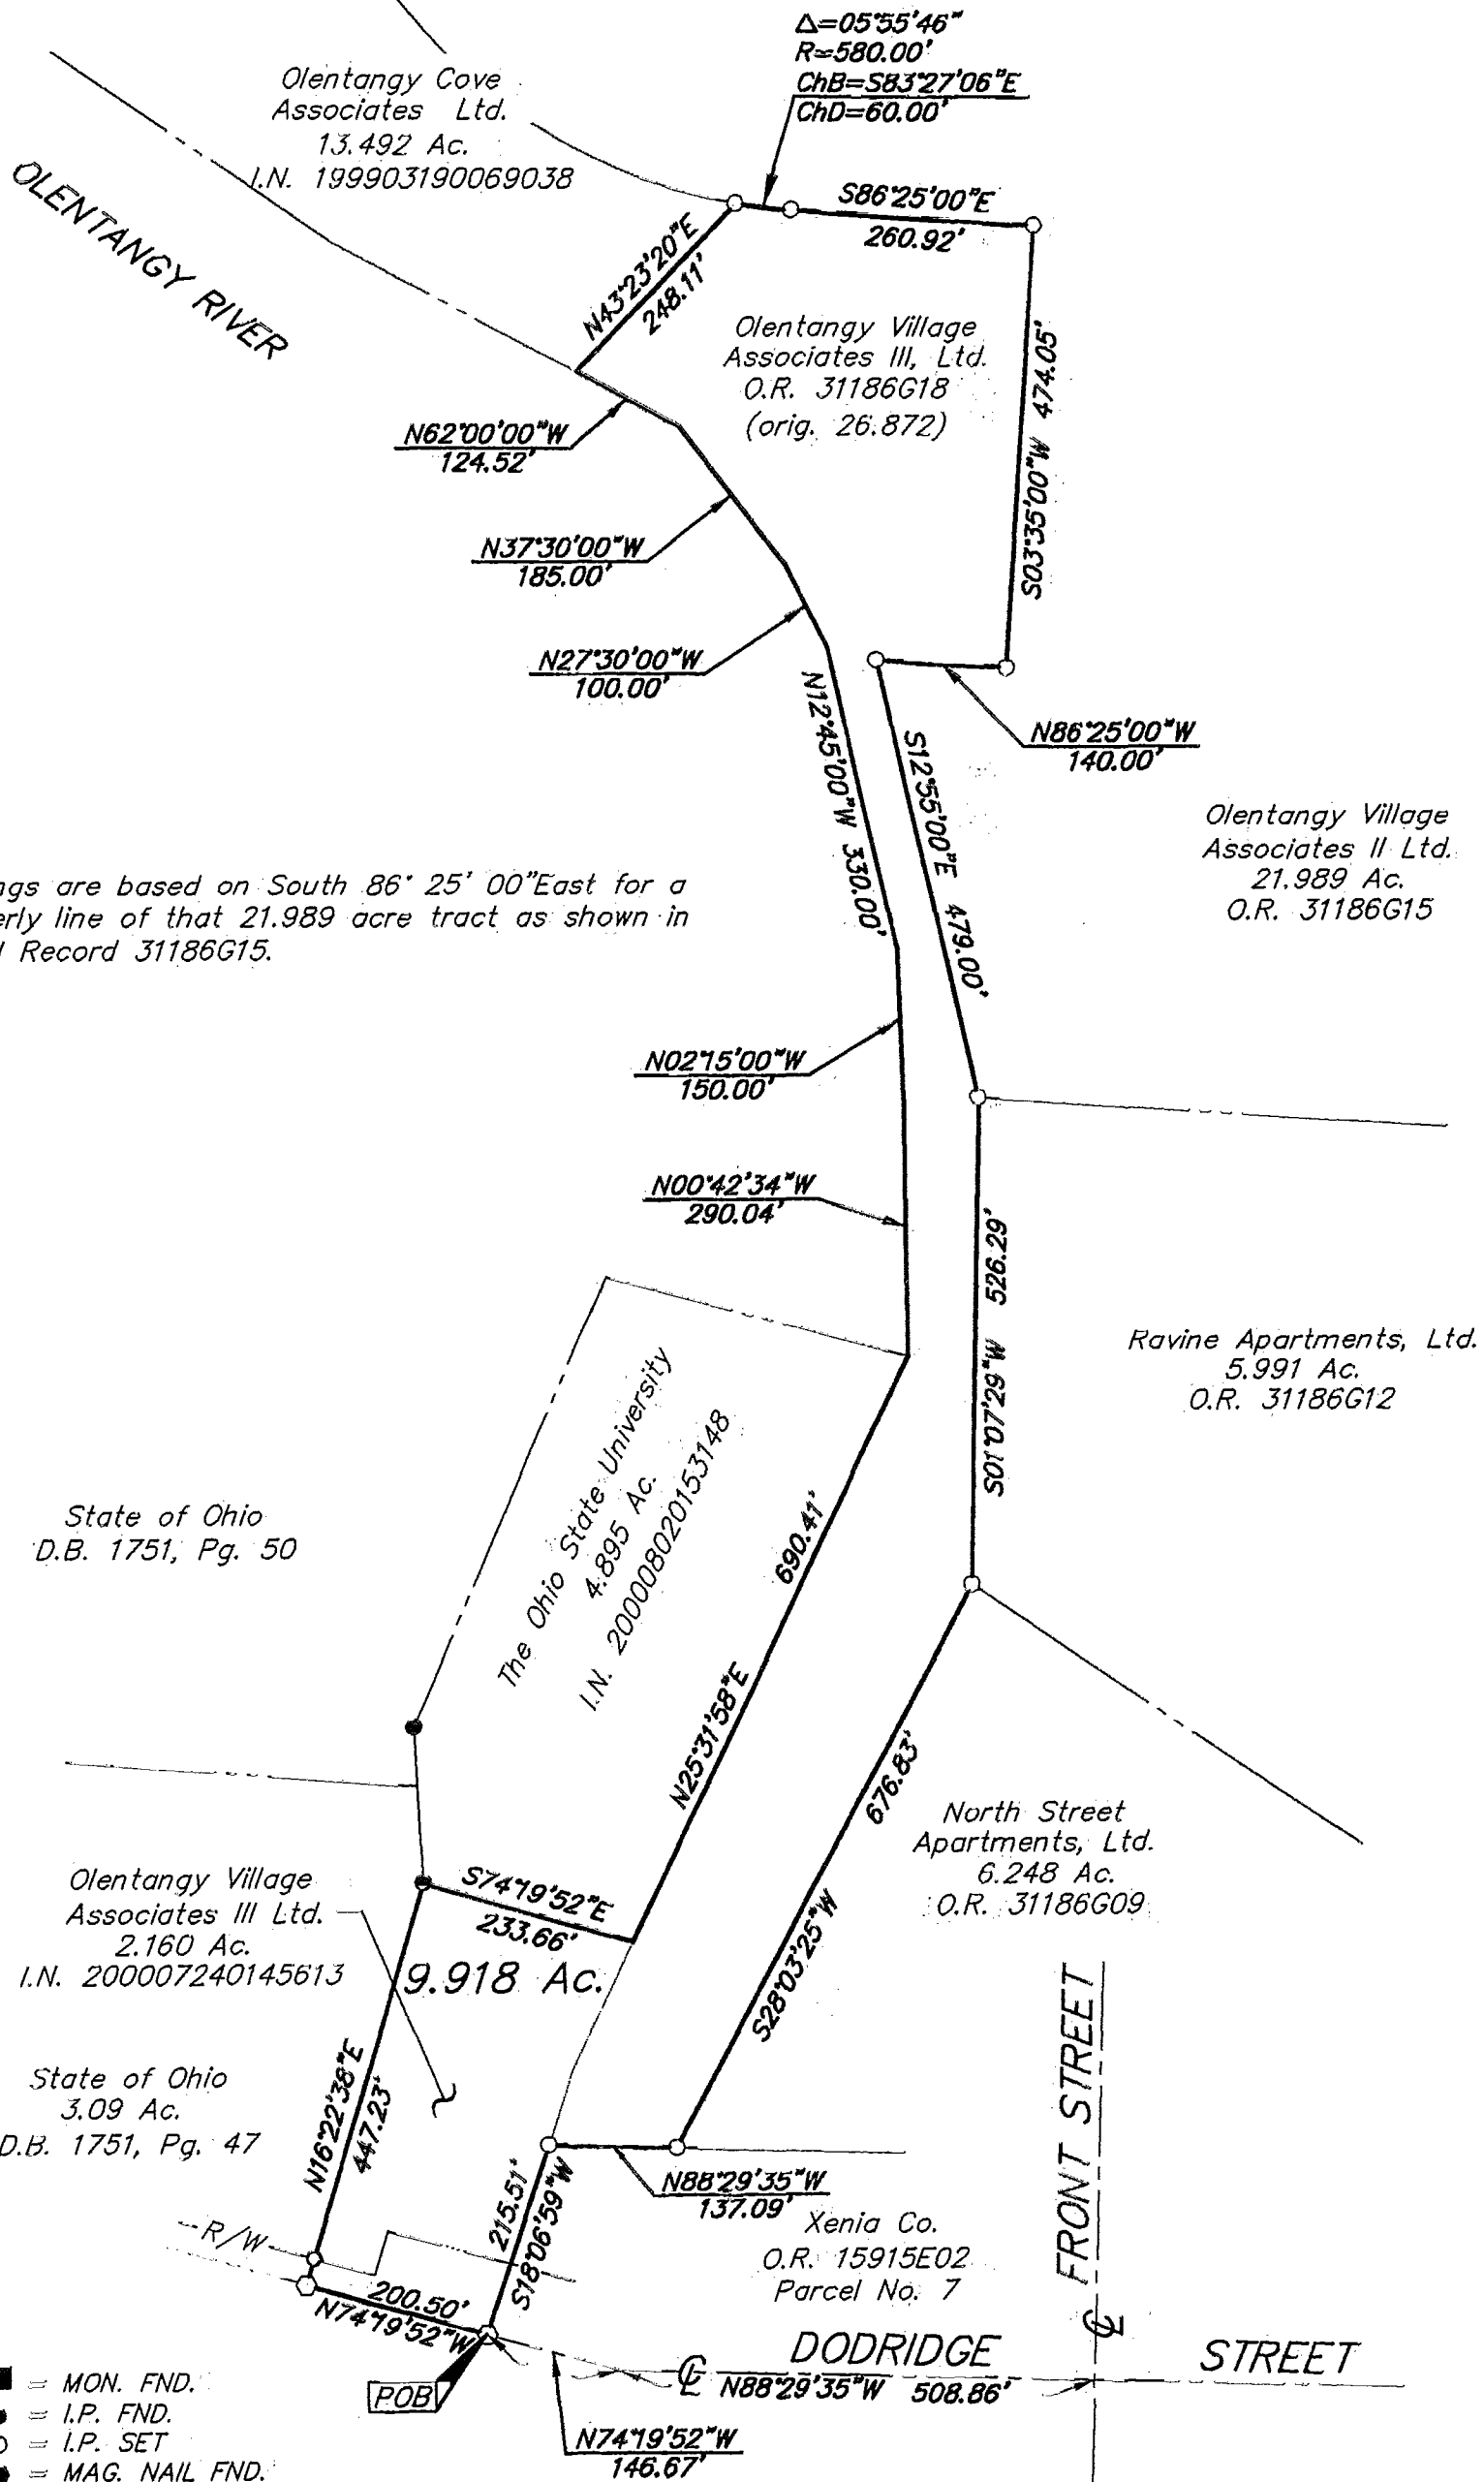


Bearings are based on South 86° 25' 00" East for a southerly line of that 21.989 acre tract as shown in Official Record 31186G15.

- = MON. FND.
- = I.P. FND.
- = I.P. SET
- = MAG. NAIL FND.
- = MAG. NAIL SET
- ▲ = R.R. SPK. FND.
- △ = R.R. SPK. SET
- ◆ = P.K. NAIL FND.

I.P.S Set are 1 3/16" I.D. Iron pipe W/ cap inscribed EMH&T.



GRAPHIC SCALE (IN FEET)

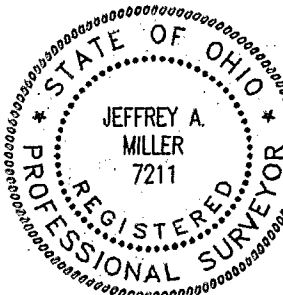

**E.M.H.&T. INC.**

By Jeffrey A. Miller 11-9-00  
 Professional Surveyor No. 7211

Re-Survey

2-58-1  
 02-06-06