

182607375

MYERS SURVEYING CO.

2740 East Main Street, Columbus 43209 (Bexley), Ohio

R-48

LOTS 11, 12, 13, & PART OF LOT 10, WOODBINE PLACE, COLUMBUS, OHIO FOR


GEORGE R. MICHAEL AND/OR LUCILLE KUMNICH

P.B. 18 Page 49
Scale 1"=20'


Franklin Co. Rec. Office

12-30-'88

Revised 2-23-'89

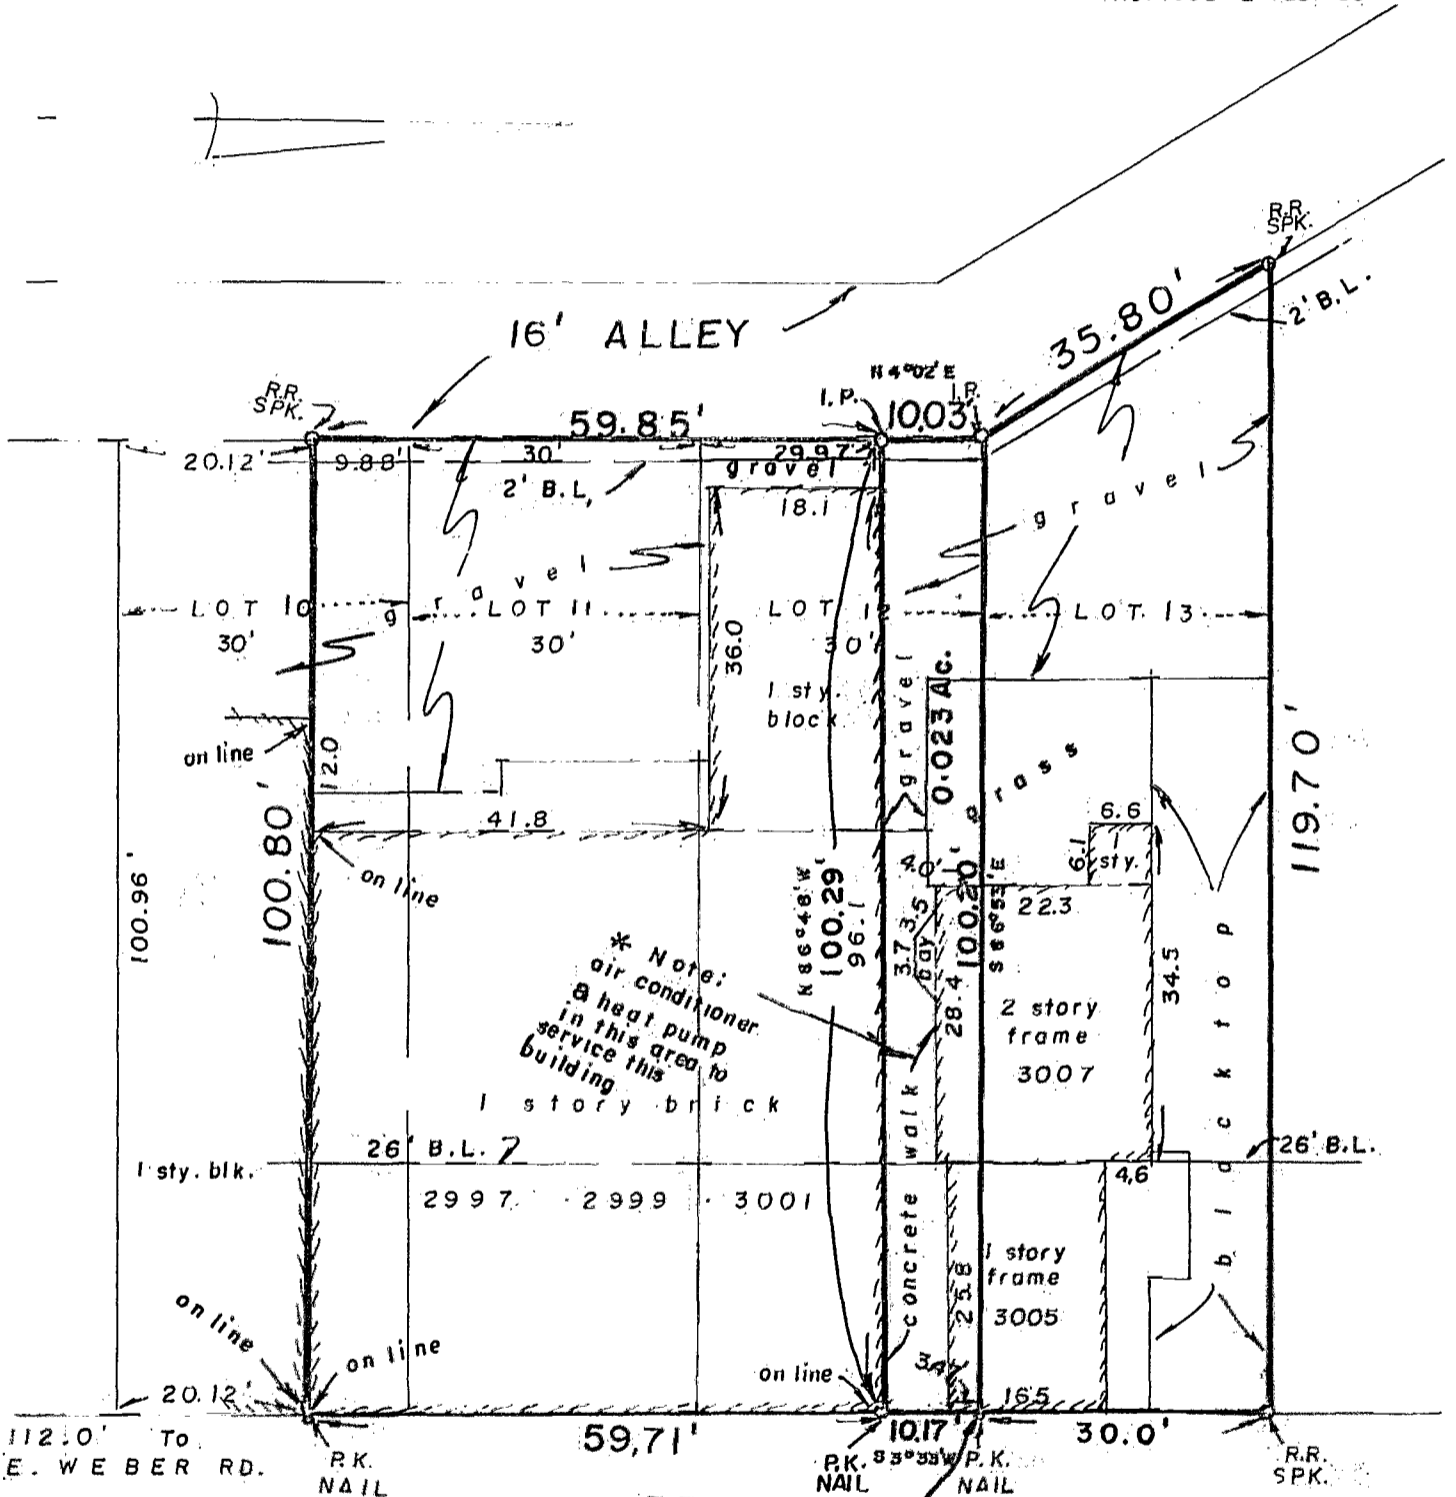

N.E. Cor. Lot 12
& Point of Beginning
INDIANOLA AVE. 65'

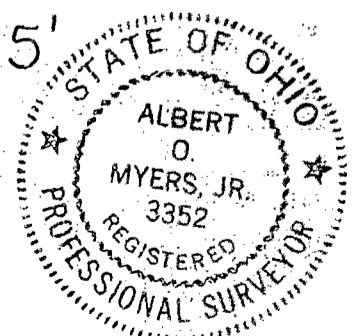

MYERS SURVEYING CO.

By *Albert O. Myers, Jr.*
Registered Surveyor

MICHAEL & KUMNICH 18-12-29-88, 14-02-23-89

F D I V G