

SURVEY OF 8.364 ACRES IN VIRGINIA MILITARY SURVEY #875,  
FRANKLIN TWP, FRANKLIN COUNTY, OHIO - ALSO KNOWN AS  
3775 TRABUE ROAD

SURVEY FOR IRENE JASYS - 4460 DUBLIN RD., CO. O. 43220

18-B

JULY 14, 1986

86-07225


86-07250

79857262

CITY OF COLUMBUS  
RAYMOND MEMORIAL GOLF COURSE

TRABUE RD.


TO HAGUE AVE.  

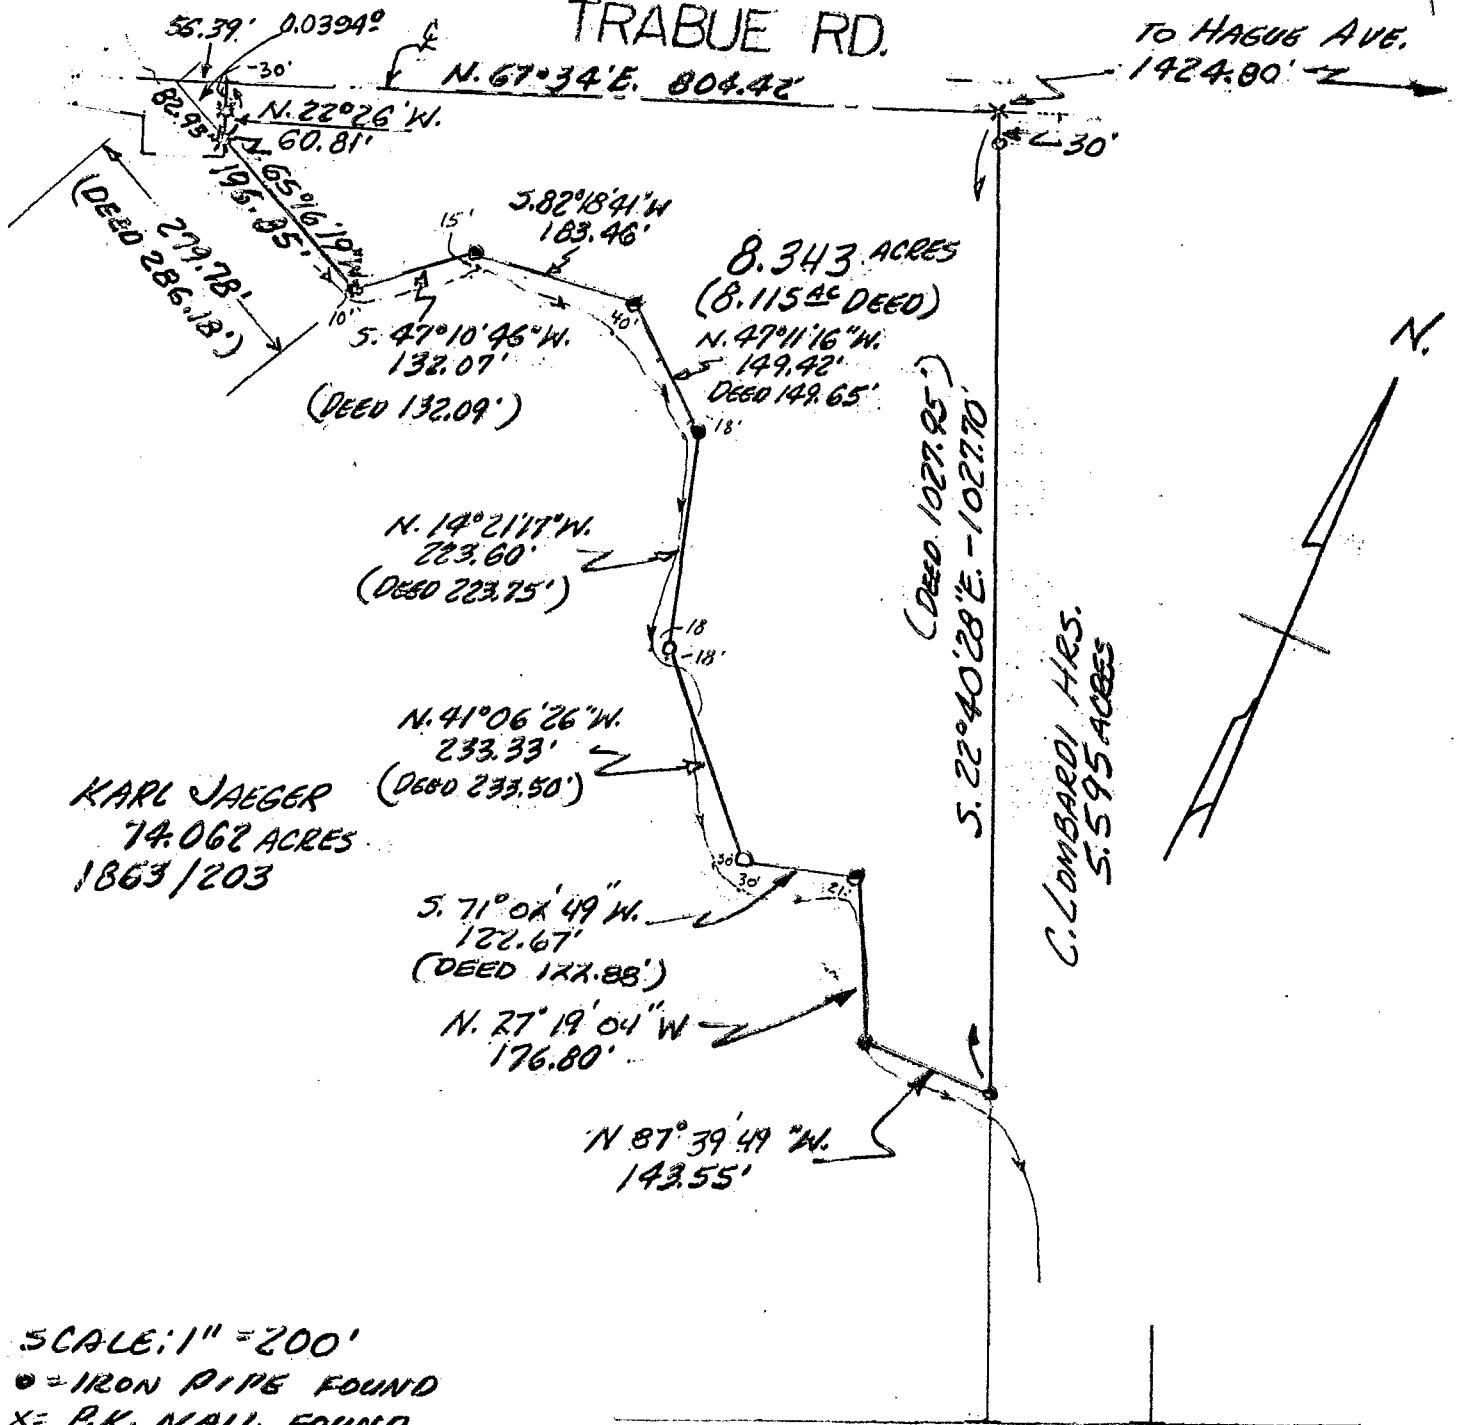

KARL JAEGER  
74.062 ACRES  
1863/203

8.343 ACRES  
(8.115 AC DEED)

SCALE: 1" = 200'  
 ○ = IRON PIPE FOUND  
 X = P.K. NAIL FOUND  
 \* = IRON PIPE SET  
 ~~~~~ STREAM HAS OF JULY 1986

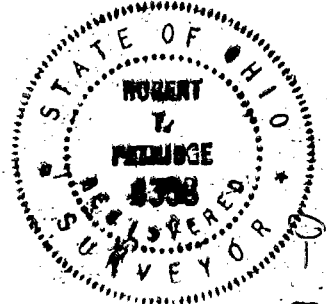

R. T. PATRIDGE & ASSOCIATES  
PROFESSIONAL LAND SURVEYORS

4466 DUBLIN RD.  
COLUMBUS, OHIO 43220  
OFFICE: (614) 876-2178  
RES. (614) 876-4067

*Robert J. Patridge*  
PROFESSIONAL SURVEYOR

NO. 4338