

# Harry L. Greene, Surveyor


2160 Tremont Center, Columbus, Ohio 43221

0-18-C

PLAT SHOWING SURVEY OF 0.5785 ACRES, CITY OF COLUMBUS, FRANKLIN COUNTY, OHIO, OUT OF ORIGINAL 4.69 ACRES CONVEYED TO THOMAS R. SABATINO, AS SHOWN OF RECORD IN OFFICIAL RECORDS 10763 J10, RECORDER'S OFFICE, FRANKLIN COUNTY, OHIO.

80857150  
80857175

PB. Page Recorders Office, FRANKLIN County, Ohio.  
Scale 1" = 100 Date April 3, 1989

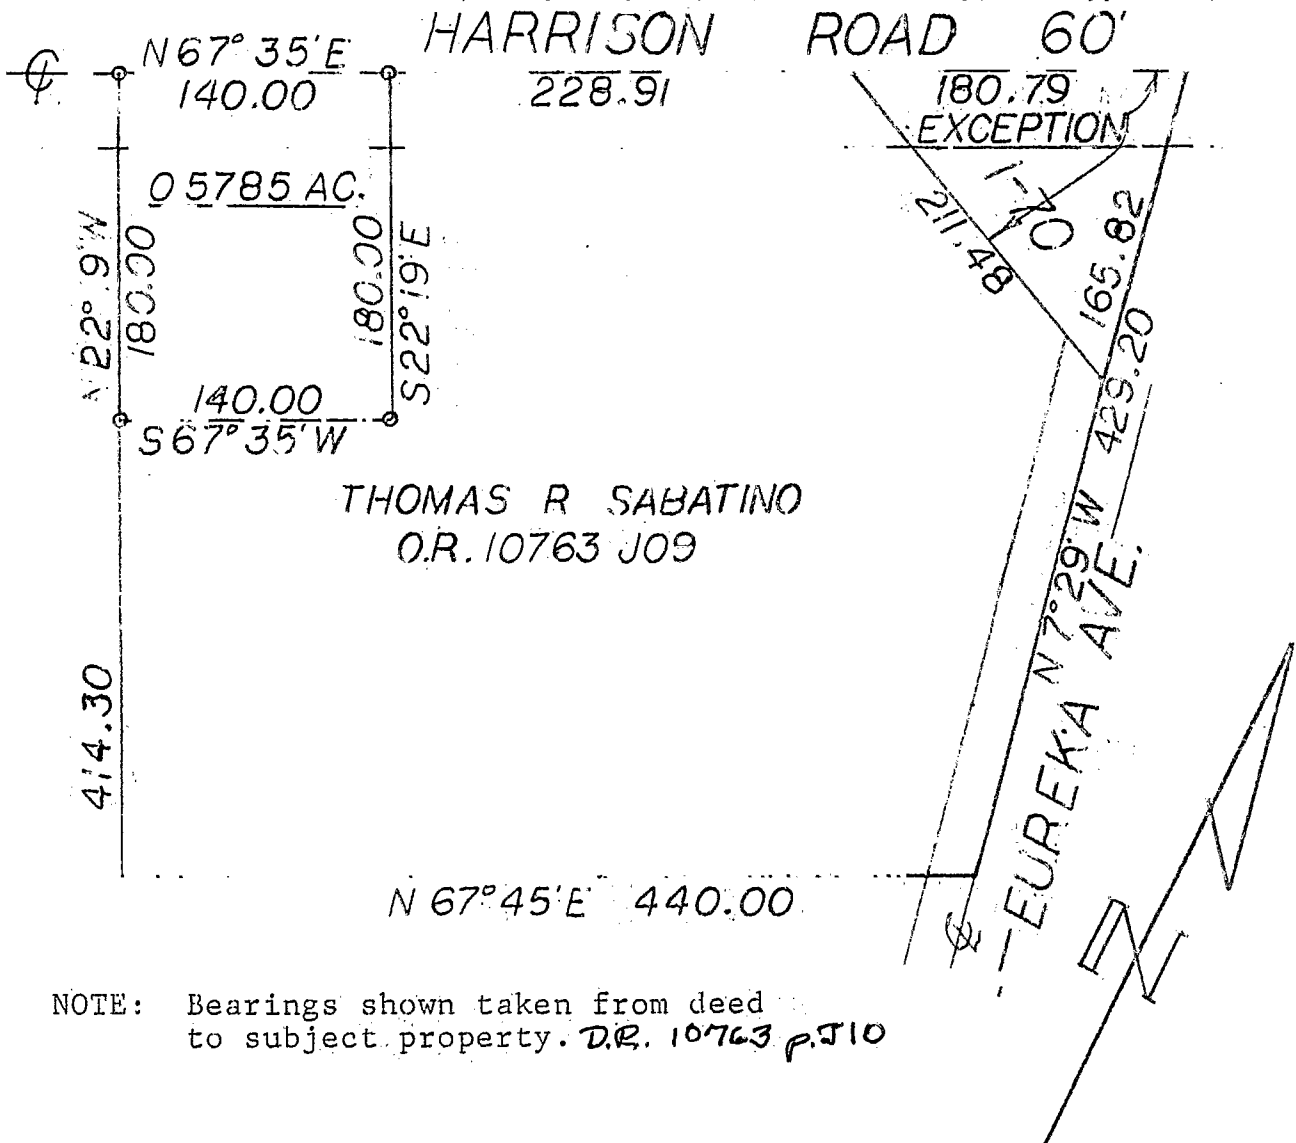

THOMAS R SABATINO  
O.R. 10763 J09

NOTE: Bearings shown taken from deed to subject property. D.R. 10763 P. J10

I hereby certify the above plat has been prepared from actual survey of the premises

*Harry L. Greene*  
Harry L. Greene, Registered Surveyor, No. 1105

0-8-8  
FRANKLIN Twp.