189.35 7500

M-21

Myers Surveying Company, Inc.

2740 East Main Street, Columbus 43209 (Bexley), Ohio
614-235-8677 FAX: 614-235-4559

A Boundary Survey prepared for and certified to:
Mr. Rannells Bauman and/or Mathews, Click & Bauman

Legal Description: Lot 25 and 22 feet off East side Lot 47 Meridian Addition Plat Book 5, Page 22 Franklin County Recorders Office.

Applicant:

Posted Address: 1025 Concord Ave., Columbus, Ohio

Apparent Encroachments: 1) None

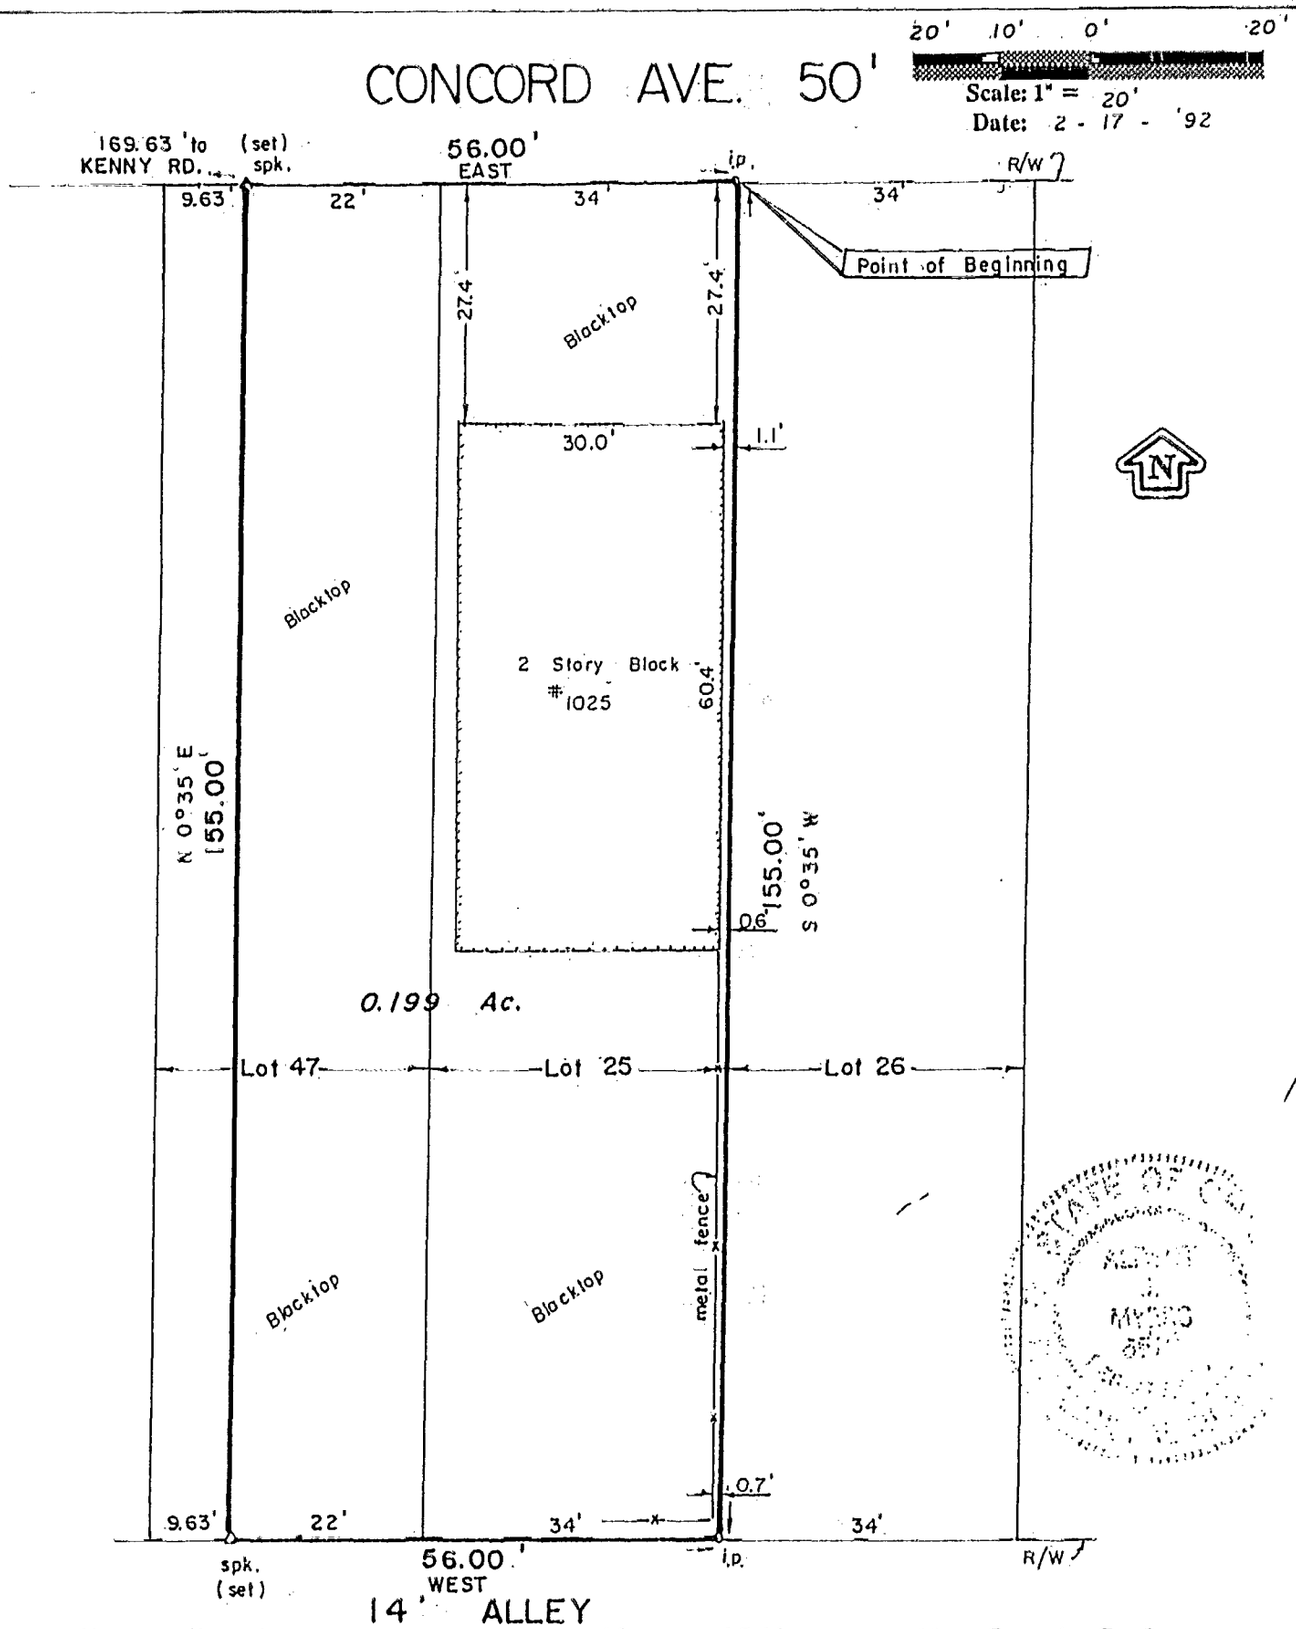

We hereby certify that the foregoing Boundary Survey was prepared from actual field measurements in accordance with Chapter 4733-37 Ohio Administrative Code. Iron pins set are 30"x1" O.D. with an orange plastic plug inscribed "P.S. 6579", unless otherwise noted. Basis of bearing is the south line of Concord Ave. assumed EAST.

Myers Surveying Co., Inc.

By _____
Professional Surveyor

Myers Order No. - 7-92-02-13	Rec.	Field	DWG	Ltr.	Ck.
		AJM	mf		

12-W