

183/077.25

# M-E ENGINEERING INC.

CIVIL DIVISION

500 SOUTH FRONT STREET

COLUMBUS, OHIO 43215


PHONE (614) 469-4903

FAX (614) 469-4989


○ IRON PIN SET

THE AREA SHOWN HEREON LIES WITHIN ZONE C, FEMA MAP PANEL NO. 390170 0065 B

NORTH

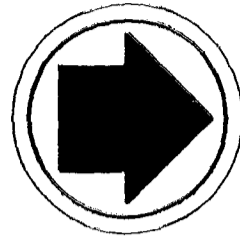


20' ALLEY

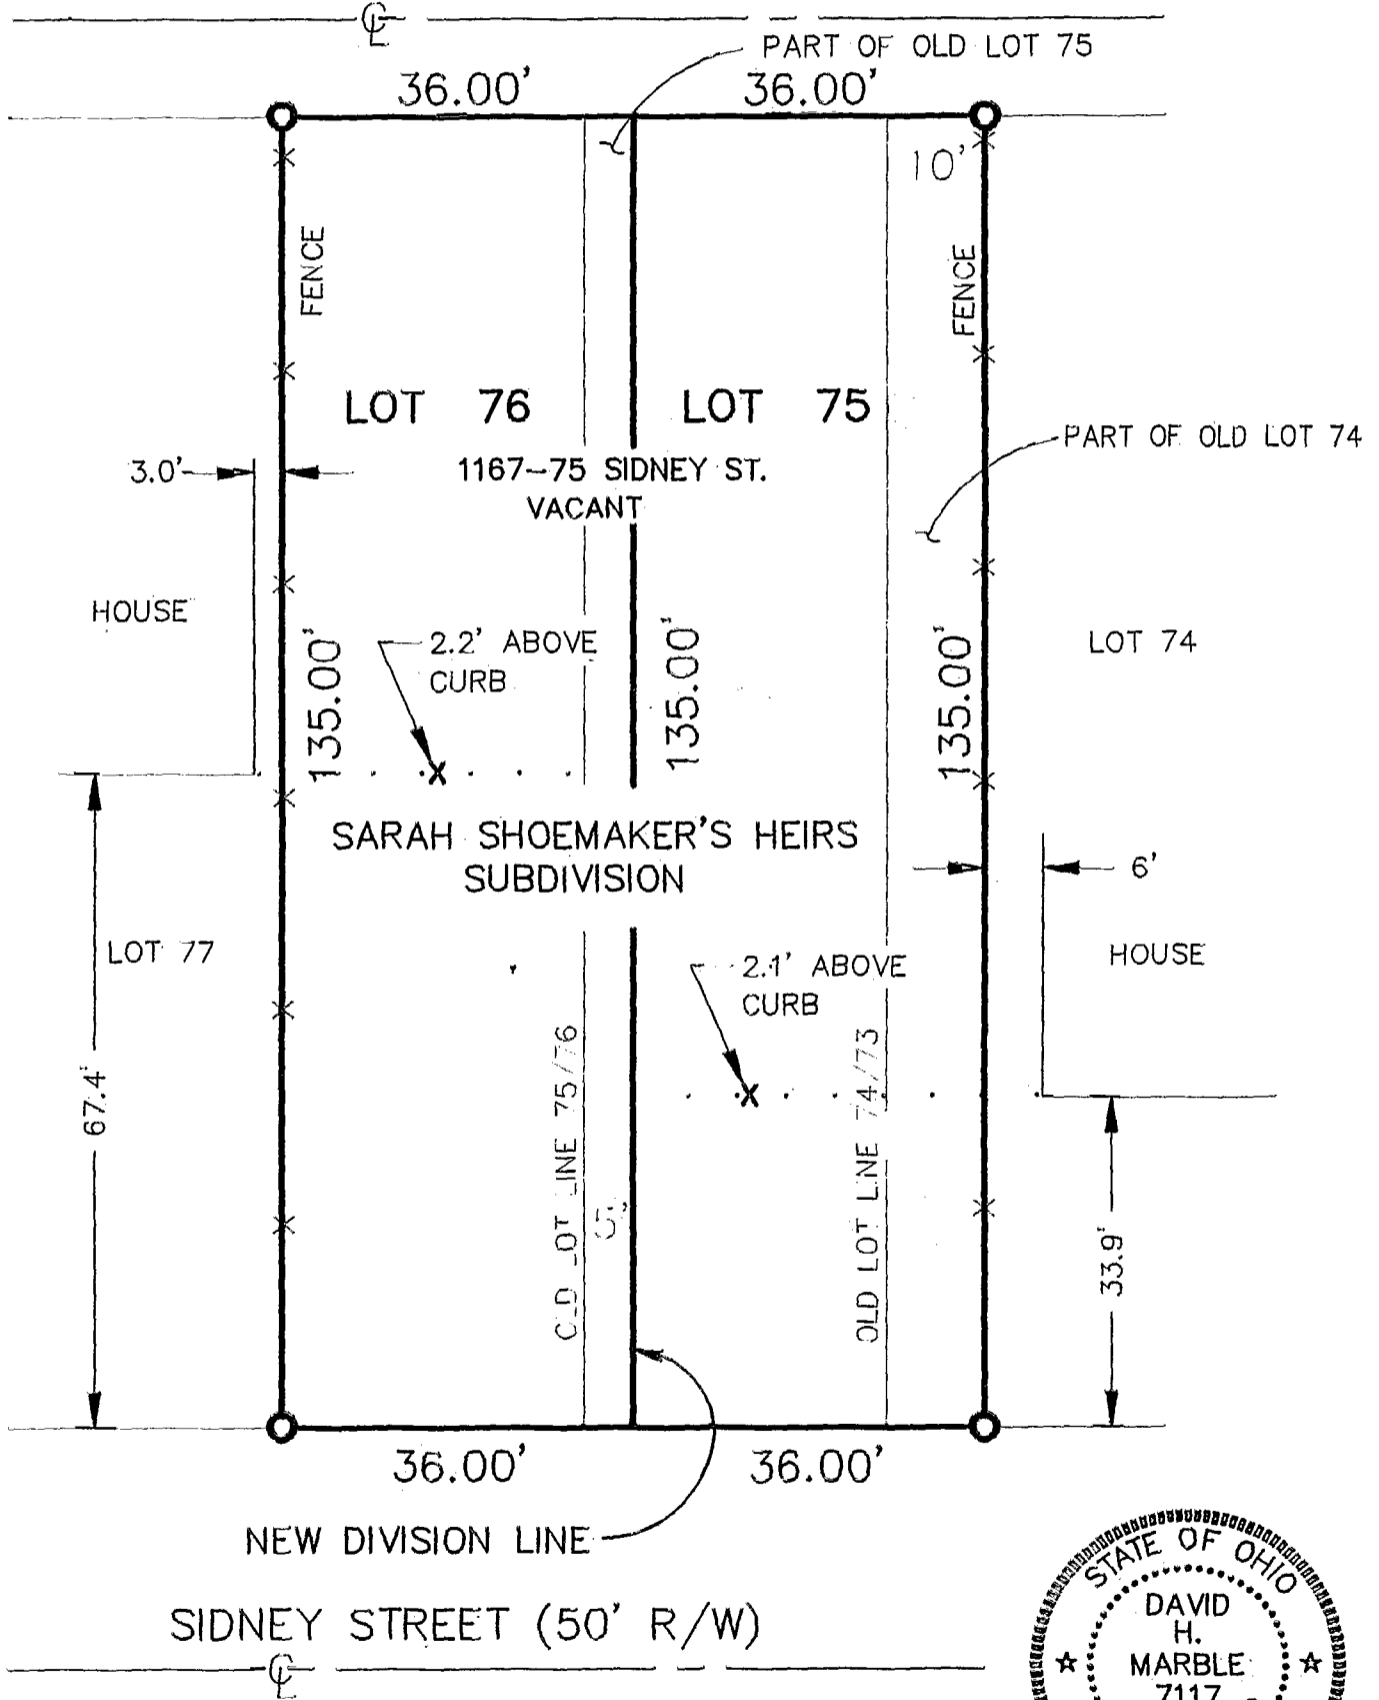

DATE 6/28/94 943049  
 REVISED DATES JOB NUMBERS  
 10/19/94-NEW DIVISION LINE

SCALE 1" = 20'

SURV'D	DRAWN	CHECKED
JK	DHM	

BY  7117  
 REGISTERED SURVEYOR No.

0-360