MYERS SURVEYING CO.

2700 East Main Street
COLUMBUS 9 (BEXLEY), OHIO

PART LOT 33 THEO. LEONARD'S HEIRS SUB. COLUMBUS, OHIO

THEODORA ROBERTS TRUSTEE

P.B. 4 Page 396
Scale 1" = 100'

Franklin Co. Rec. Office
9-16-59

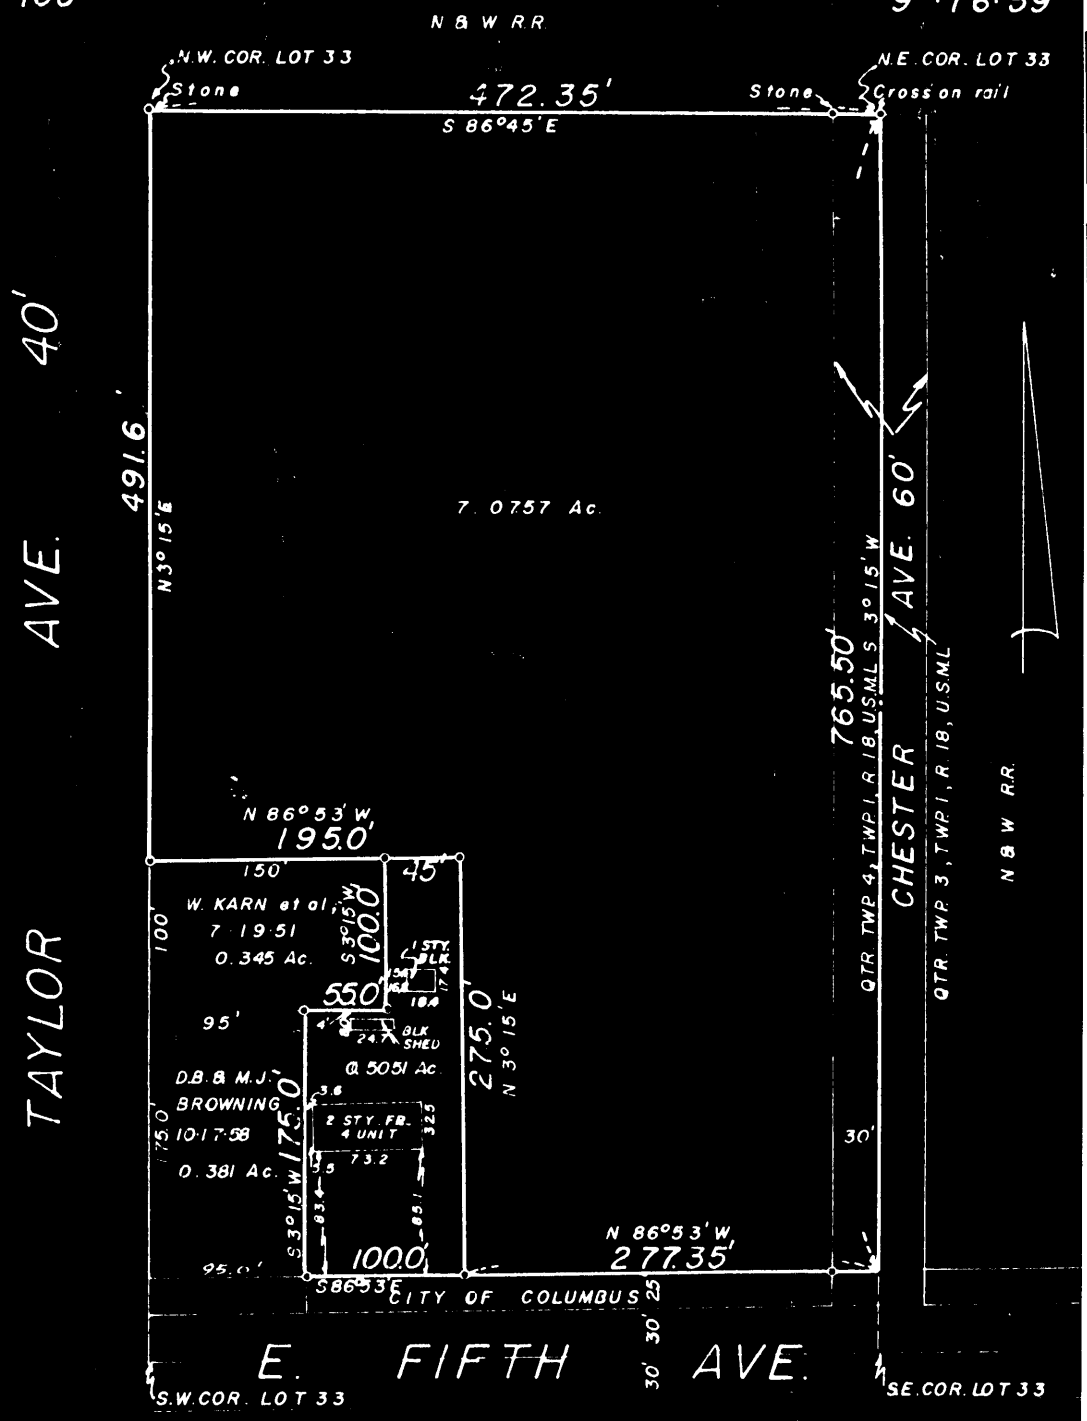

We hereby certify that the foregoing plat was prepared from an actual survey of the premises. No side line or principal building is less than dimension shown. Iron pins not set unless indicated thus ○.

MYERS SURVEYING CO.

BY C. W. Deleett
Registered Surveyor