

18385 7200


A Survey of
0.0966 acres out of a 1.654 acre tract of land
deeded to Barry B. Zacks, located in Section 3,
Township 5, Range 22, United States Military
Lands.

Plat Book: _____

County: Franklin

Page: _____

City: Columbus

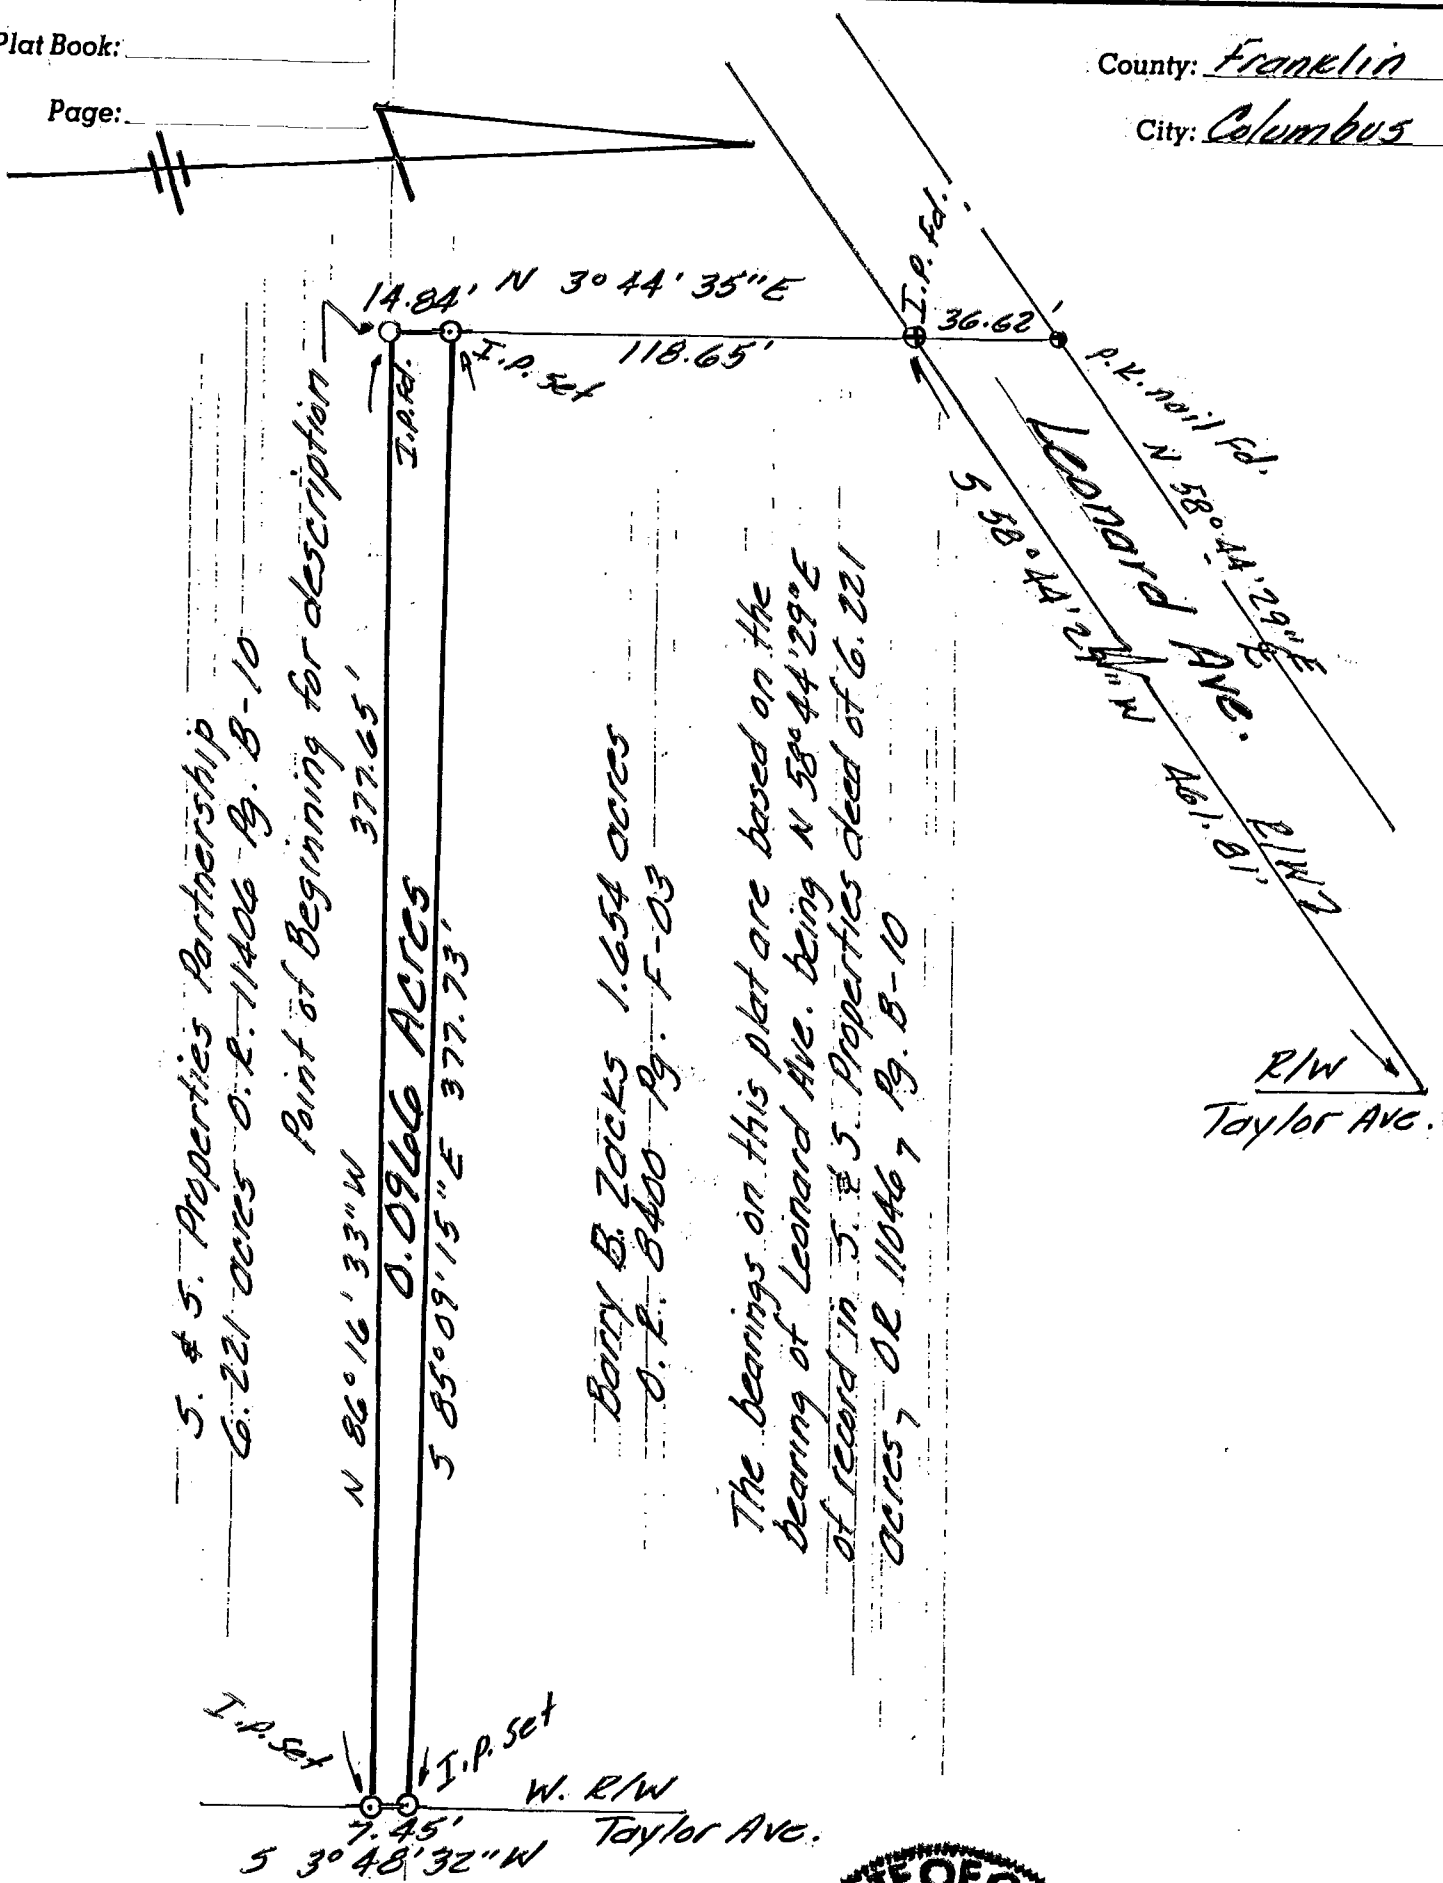

5. & 5. Properties Partnership
O. L. 11406 Pg. B-10

Point of Beginning for description

0.0966 ACRES

Barry B. Zacks 1.654 acres
O. L. 8400 Pg. F-03

The bearings on this plat are based on the
bearing of Leonard Ave. being N 58° 44' 29\"/>

LEONARD AVE.
N 58° 44' 29\"/>


R/W
Taylor Ave.

I do hereby certify that the foregoing plat was prepared from
an actual survey of the premises shown hereon. No principal
line of any building is any closer to the lot line than the
dimension shown. Iron pin corners were not set unless indi-
cated thusly:

Rev.: 3/7/90 LHA

Date: 12/22/09

Scale: 1" = 50'

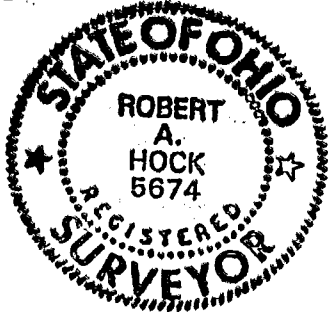

Hock Surveying Co.
5440 Darcy Rd.
Columbus, Ohio

Robert A. Hock
Ohio Surveyor No. 5674

18385