


PLAT OF SURVEY  
 FOR  
 OUR MASONRY, INC.  
 0.388 ACRE TRACT  
 PART OF LOTS 24 THROUGH 20  
 SECOND PLAT OF THEODORE LEONARD'S  
 EAST COLUMBUS LANDS  
 PLAT BOOK 3, PAGE 190  
 CITY OF COLUMBUS  
 COUNTY OF FRANKLIN  
 STATE OF OHIO

I-670 (R/W VARIES)

All iron pins set are 5/8 inch rebar with a yellow identification cap marked "Rolling 5569".

THE BEARINGS ON THIS PLAT ARE BASED UPON THE CENTER-LINE OF LEONARD AVENUE AS BEING NORTH 57 DEGREES 15 MINUTES 00 SECONDS EAST.

THIS PLAT WAS PREPARED BY HARRY L. GREENE, ENGINEERING AND SURVEYING, AND IS A TRUE AND ACCURATE REPRESENTATION, TO THE BEST OF MY KNOWLEDGE AND BELIEF, OF A SURVEY MADE BY SAME IN AUGUST 1997.

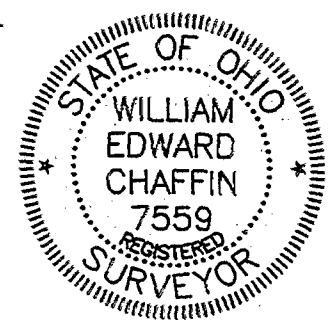

*William Edward Chaffin*  
 WILLIAM EDWARD CHAFFIN  
 REGISTERED SURVEYOR NO. 7559

REVISED: 11/13/97

DRAWN BY: R. CHAFFIN		DATE: 09-12-97		- PLAN PREPARED BY -	
CHECKED BY: W. CHAFFIN		DRAWING NO.: SURVEY.DWG		HARRY L. GREENE, ENGINEERING AND SURVEYING	
SHEET NO.: 30117H		SHEET 1 OF 1		2122 TREMONT CENTER COLUMBUS, OHIO 43221 (614) 486-0714	

