FRANKLIN TWP.

0-18-D

MOCHADEN-LIPES-ROUSCULP, INC.
CONSULTING ENGINEERS
2207½ N. HIGH ST.
COLUMBUS, OHIO

010 115422

0-18 D
Plastic

Survey No 19

Catherine Hadley et al (4)
DB 2203. PG 539

110888

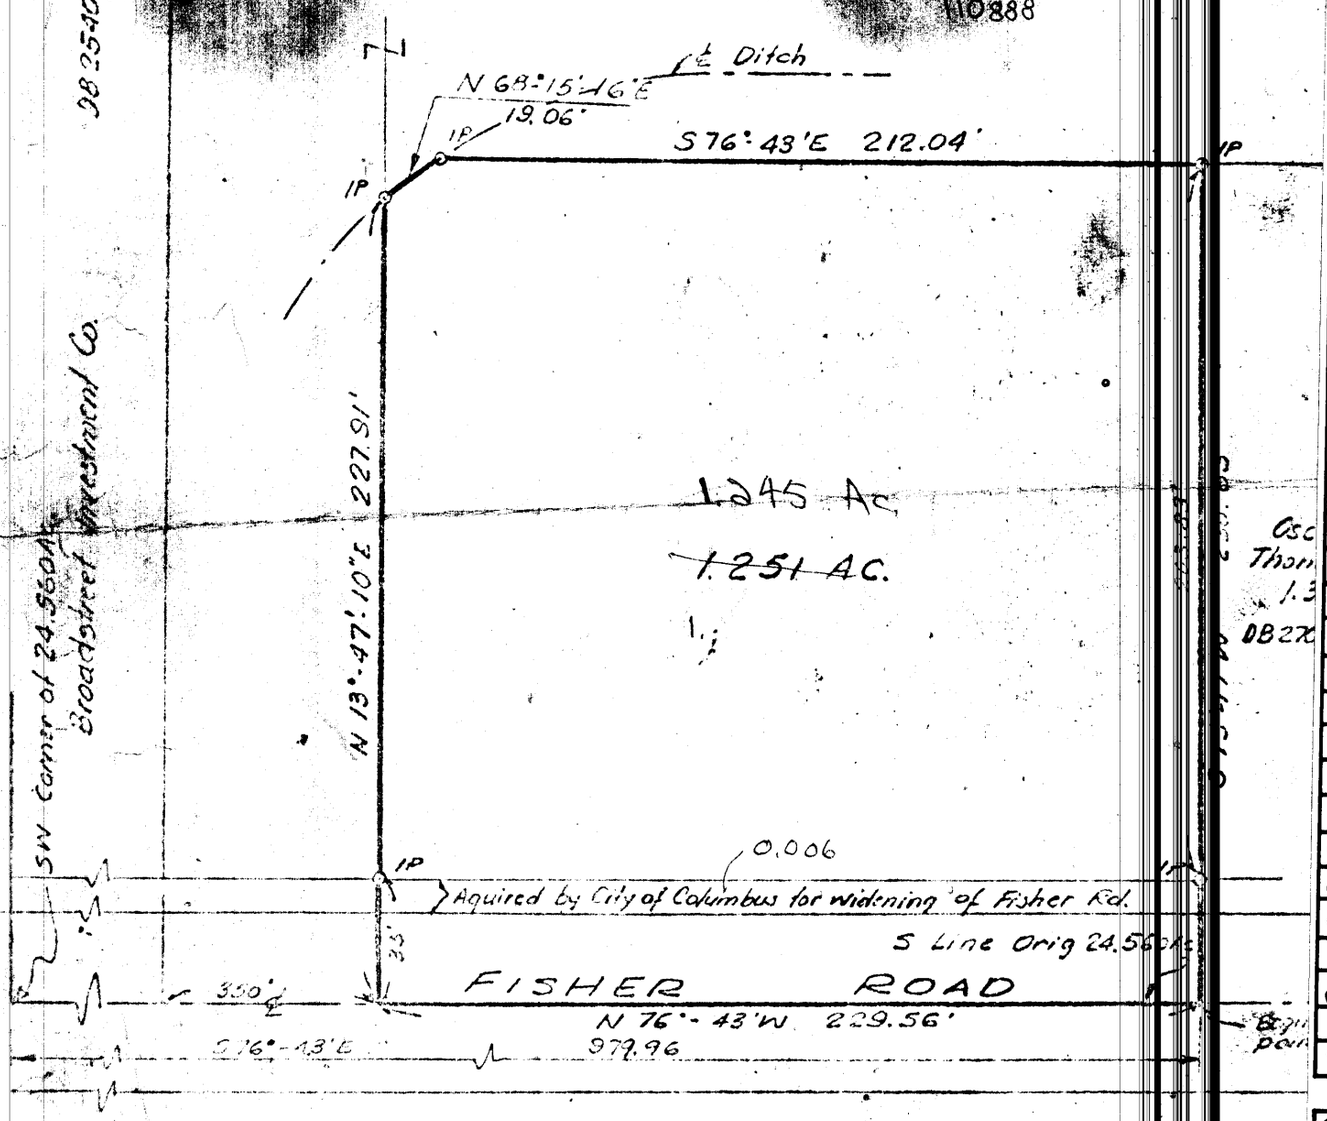

Situated in the State of Ohio, County of Franklin, City of Columbus, being 1.251 of land out of that 24.560 acre tract of land referred to as the First Parcel and desc in a deed to Catherine G. Hadley, Ben F. Hadley, Jr., Robert G. Hadley and William C. of record in Deed Book 2203, Page 539, Recorder's Office, Franklin County, Ohio.

[redacted]

Poor Original

We hereby certify that the foregoing plat was prepared from an [illegible] premises.

SCALE 1" = 50'

DRAWN	CHECKED
WR	S.E.

DATED 4-7-69 #21202
REVISED DATES 7-11-67
ORDER NUMBERS

MOCHADEN-LIPES-ROUSCULP, INC.
By [illegible]
Registered Surveyor

749857 150

1560 1120 0623 0023 W FISHER RD. 1967 0184