


M-148 23

CERTIFICATE OF SURVEY

15060715

Columbus, Ohio May 8, 1954

I hereby certify that I have this day made a survey of the premises described as "Part of Lot No. 12 (15' strip off E. side Lot No. 12) and All of Lot No. 13", as the same are of record in D. B. 1805, Pg. 544, D. B. 176, Pg. 212 and P. B. 22, Pg. 98, Recorder's Office, Franklin County, Ohio owned by Oliver F. & Alpha J. Fitch, situated in the Neffs Oak Knolls Ext. Addition, Franklin Township, Franklin County, Ohio, and that I have found the lines and marked them as shown hereon.

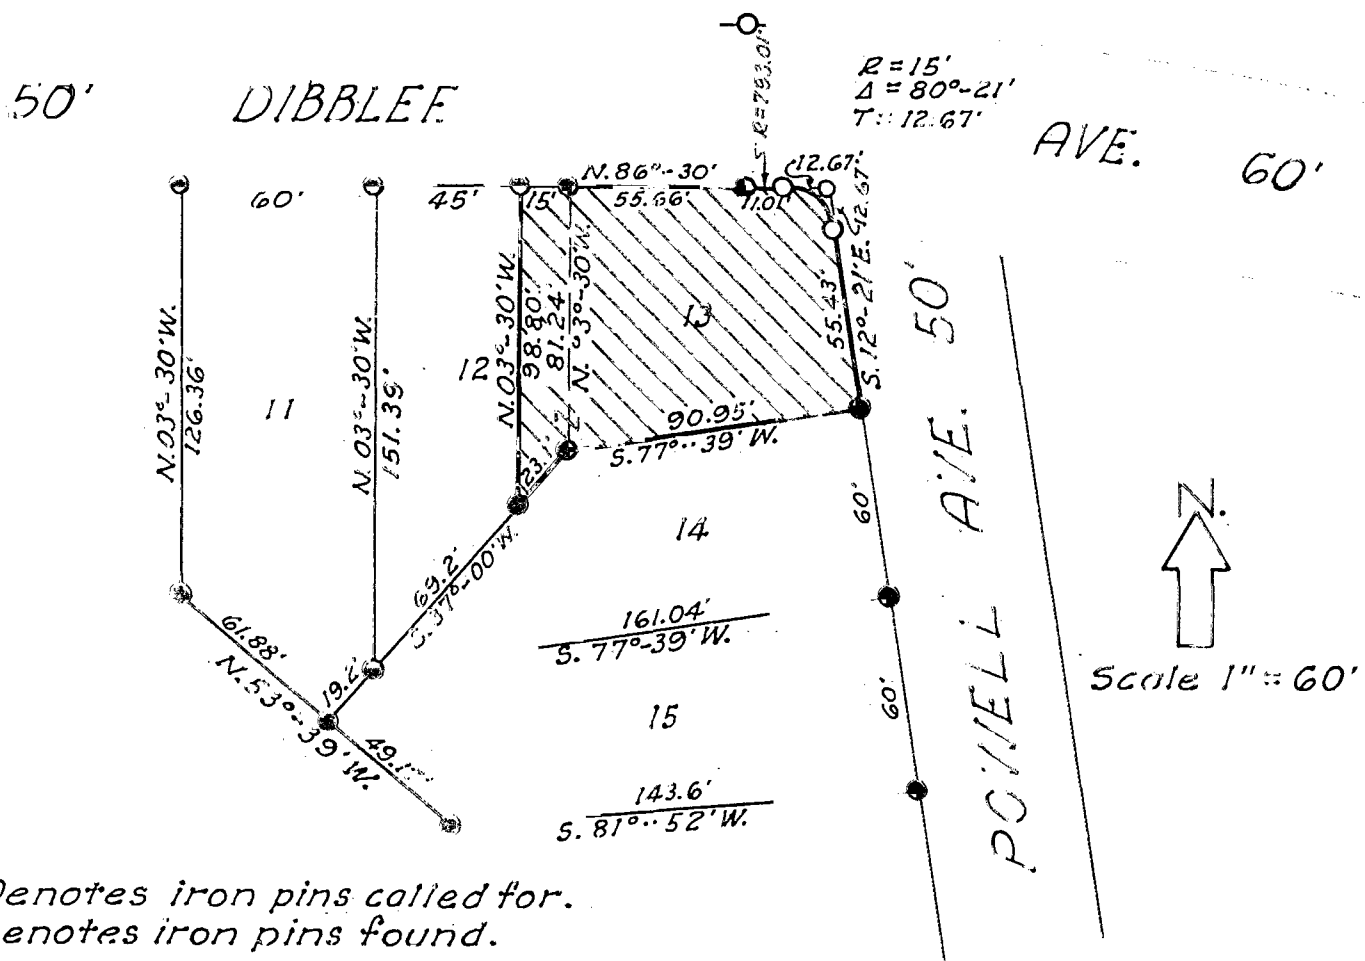

○ Denotes iron pins called for.
● Denotes iron pins found.

▧▧▧▧▧ Denotes premises surveyed for Oliver F. Fitch at his request.

Registered Surveyor No. S-4093

Wilbert C. Benedum
Wilbert C. Benedum