

180107075

Myers Surveying Company, Inc.

2740 East Main Street, Columbus 43209 (Bexley), Ohio
614-235-8677 FAX: 614-235-4559

A Boundary Survey prepared for and certified to:
Mr. Robert McDaniel

Legal Description: part of Lots 28 and 35 Franklin Heights Subdivision, Plat Book 7, Page 124 Franklin County Recorders Office

Applicant:

Posted Address: 425 Derrer Road, Columbus, Ohio



Apparent Encroachments: 1) None

JOSEPHINE AVE. 40'



Scale: 1" = 80'

Date: 9.13.91

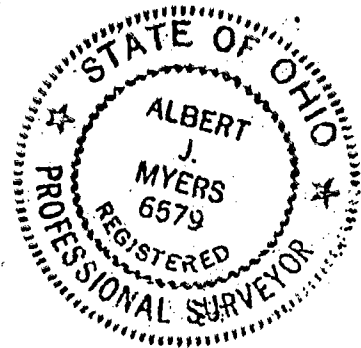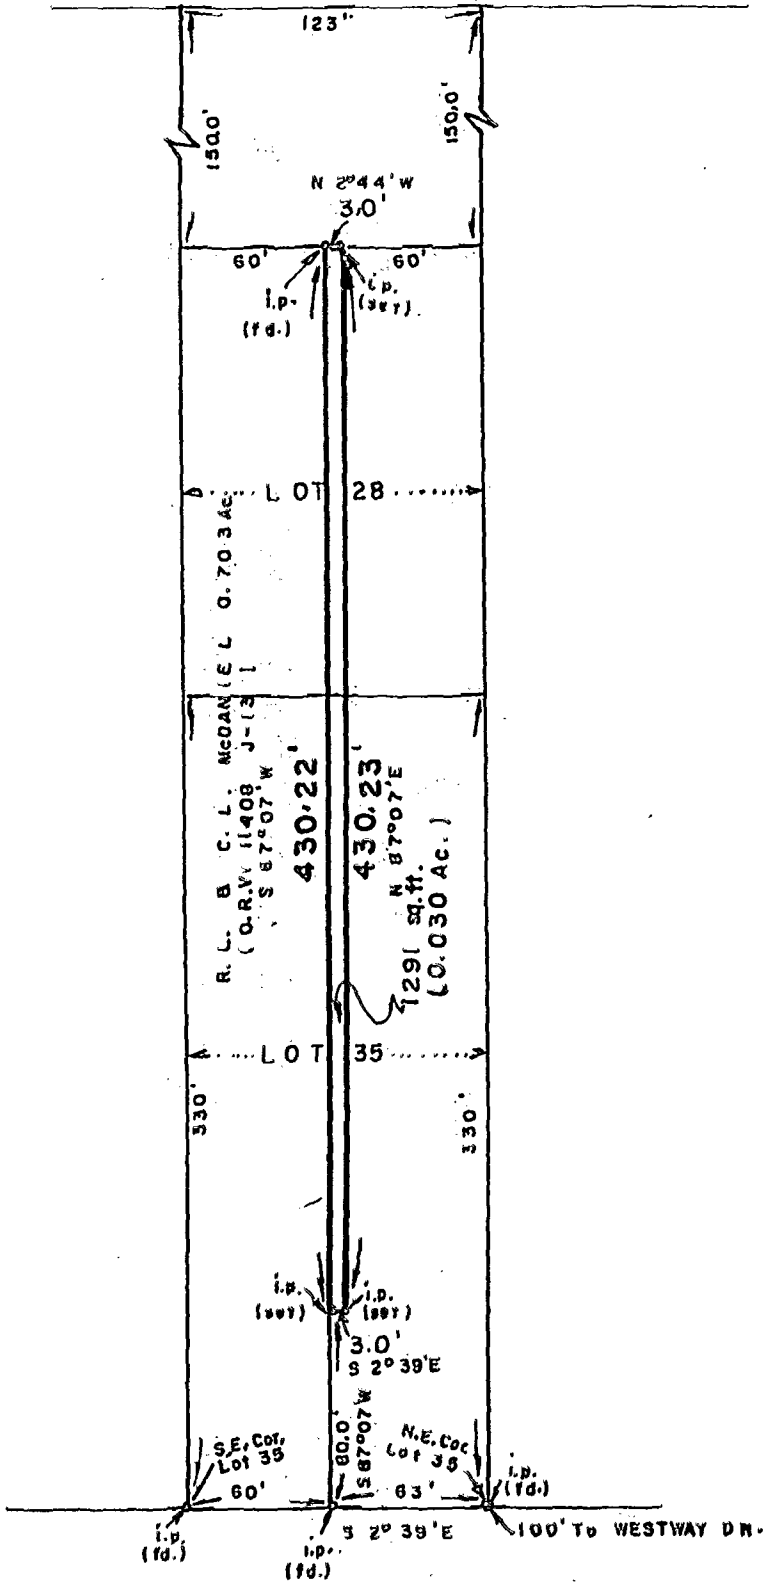

DERRER ROAD 45'

We hereby certify that the foregoing Boundary Survey was prepared from actual field measurements in accordance with Chapter 4733-37 Ohio Administrative Code. Iron pins are 30"x1" O.D. with an orange plastic plug inscribed "P.S. 6579", unless otherwise noted. Basis of bearing is ~~magnetic~~ True. P.B. 19 Pg. 78

Myers Surveying Co., Inc.

By Albert J. Myers
Professional Surveyor

Myers Order No. - 27-91-09-04

Rec.

Field JN

DWG JN

Ltr.

CK.

91-78