

LOT 8, PT. LOT 7, BLK. 37



WILSHIRE HEIGHTS ¹⁹⁰³⁵⁷⁰⁷⁵ / ¹⁸⁰⁶⁰⁷⁰⁷⁵ COLUMBUS, OHIO
FOR M-135


DR. RICHARD N. SANTHO

Plat Book 15, Page 32

Franklin Co. Rec. Office
January 20, 1989

Scale 1" = 20'

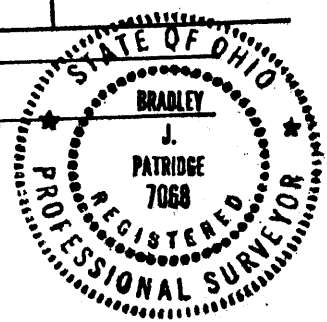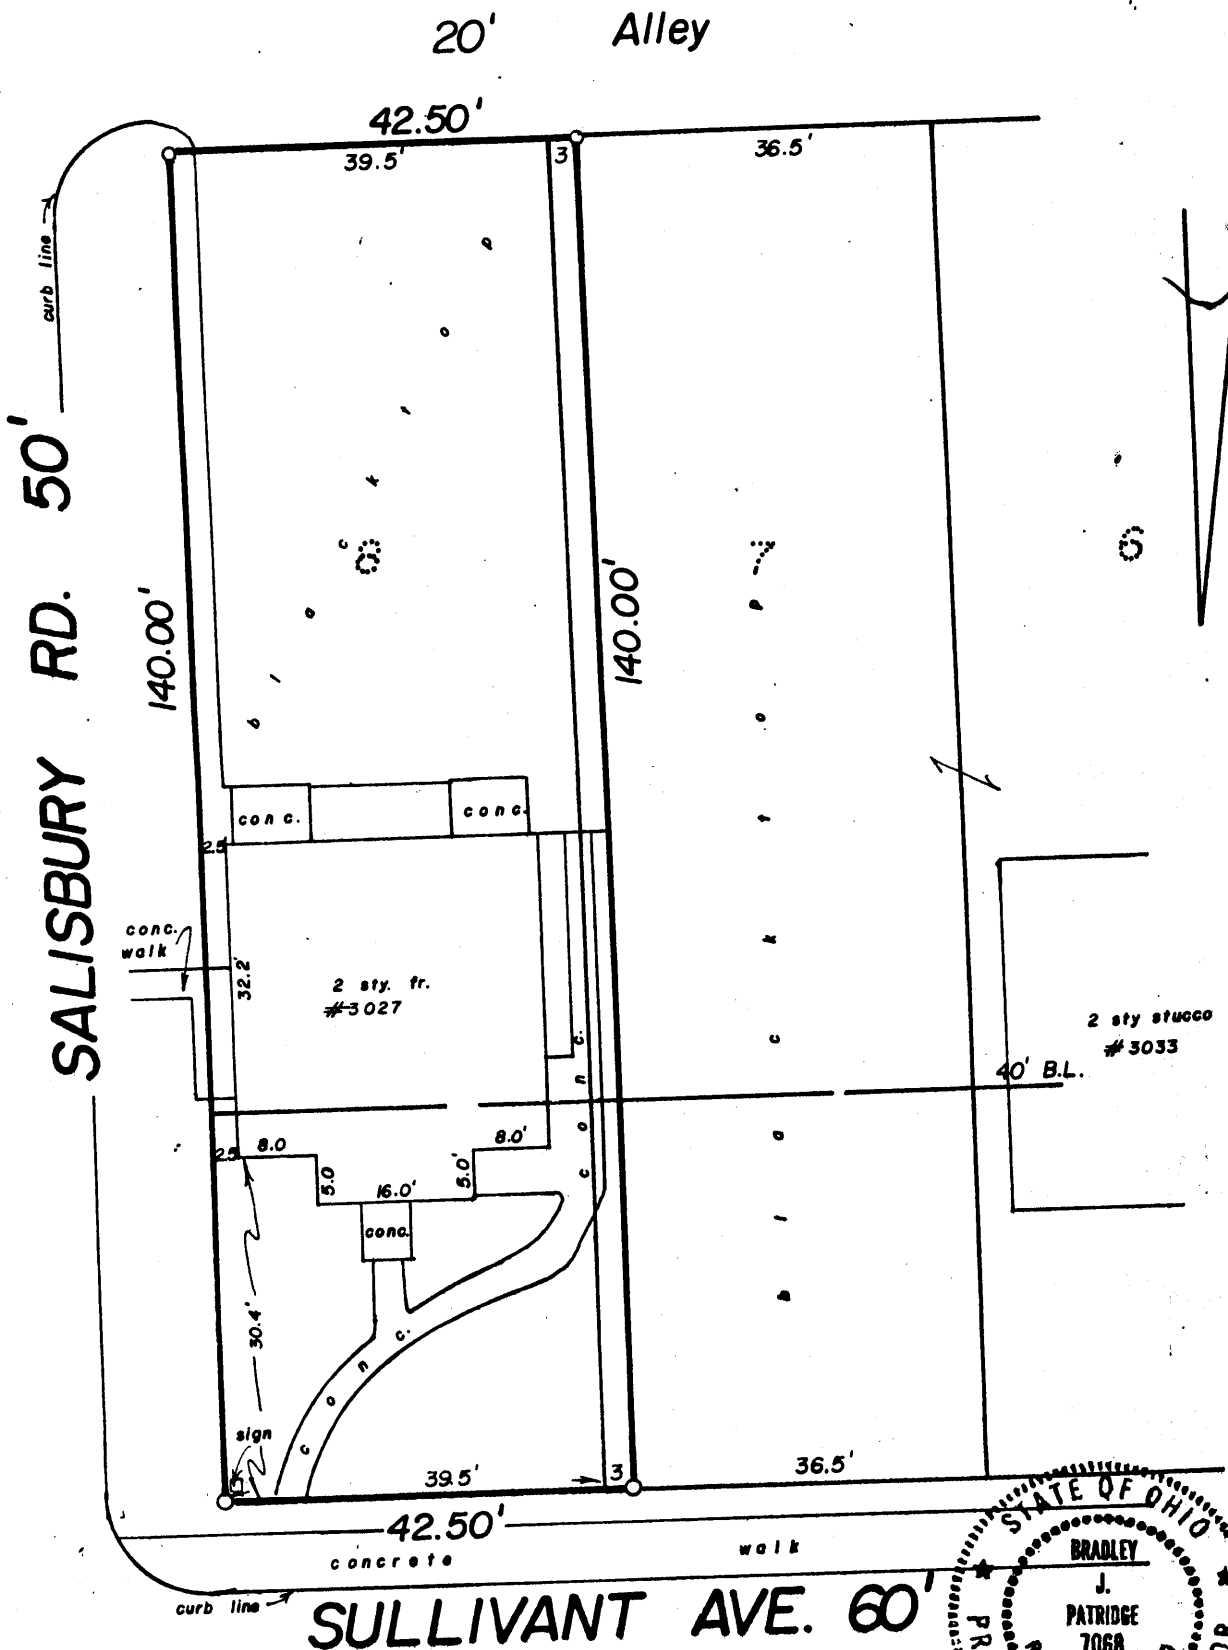

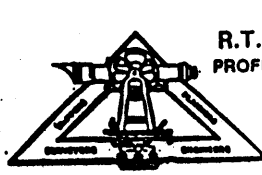 R.T. PATRIDGE AND ASSOCIATES
PROFESSIONAL ENGINEERS AND SURVEYORS
6480 DUBLIN RD.
POWELL, OHIO 43066
FAX. (614) 881-5038
TEL. (614) 881-5675

Bradley J. Patridge
Professional Surveyor No. 7068

M-135