

EVANS MECHWART HAMBLETON & TILTON,

CONSULTING ENGINEERS — SURVEYORS
GAHANNA, OHIO

XO-11C

SURVEY OF 1.544 ACRE TRACT LOCATED IN VIRGINIA MILITARY SURVEY NO. 7835 WASHINGTON TOWNSHIP, FRANKLIN COUNTY, OHIO

SCALE 1" = 100'

JULY 8, 1970
O = IRON PIN

DEED BOOK 2638, PAGE
PLAT BOOK, PAGE


0-110-1

HOUGHARD ROAD

Marion W. Wolpert

Deed = 40 Ac.


D.B. 2638, Pg. 492

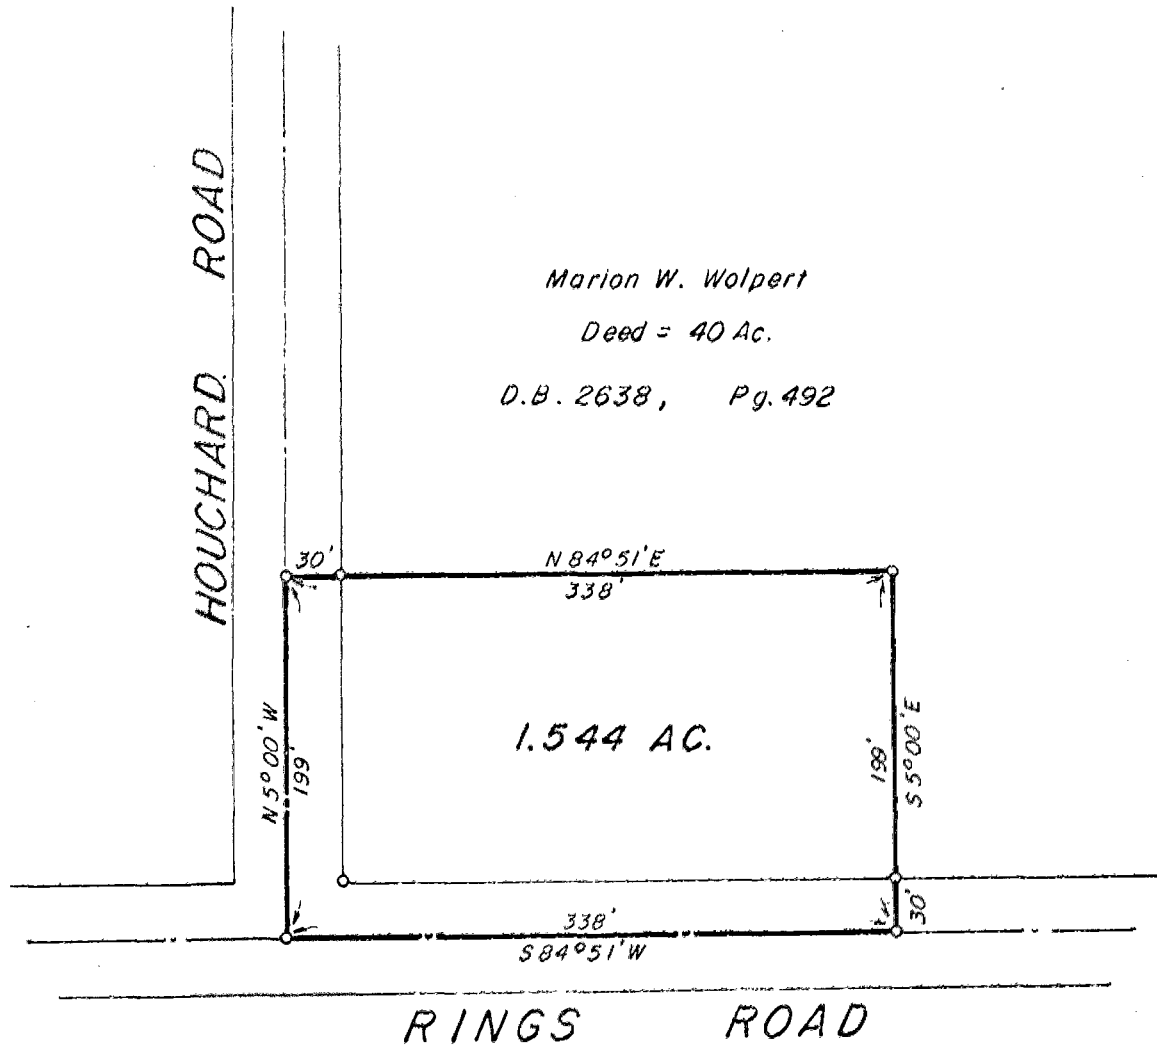

We hereby certify that the foregoing plat was prepared from an actual survey of the premises and shows the location of the boundaries.

EVANS MECHWART HAMBLETON & TILTON, INC.

BY *M. H. Mechwart*
Registered Surveyor No. 4072

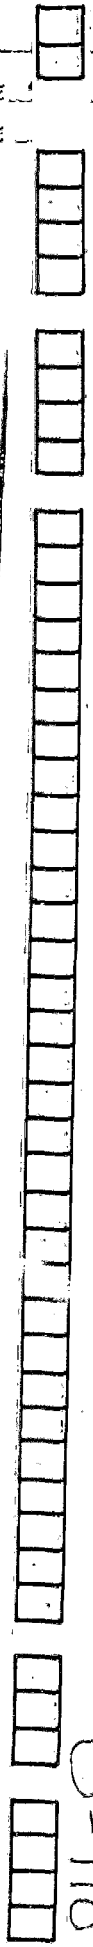

0-110-0