


G-35
Columbus

STATE ST. ~ 82.5'

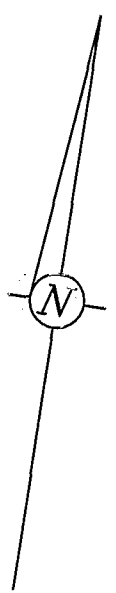

Ex. R/W N 81°35'00" E 94.75'

3/4" I.D. Iron Pipe Found

Axle Found

PLACE OF BEGIN. OF 0.410 AC. TRACT

0.14 AC. - PARCEL TWO
0.14 AC. - PARCEL ONE

GRANT MEDICAL CENTER
O.R. 14623 PG. B 07
P.N. 010-012730

GRANT MEDICAL CENTER
0.08 AC.
O.R. 27983 PG. C 18
P.N. 010-012730

N 07°59'47" W 188.48'

BEERY-SPURLOCK RENTALS
0.13 AC.
D.B. 3619, PG. 673
P.N. 010-012730

R.R. Spike Found

CENTRAL RESERVATION
D.B. 19, PG. 464

0.410 AC.

GRANT MEDICAL CENTER
0.04 AC.
O.R. 14904 PG. G 12
P.N. 010-012730

S 07°59'47" E 188.48'

SIXTH ST. ~ 60'

30.00'

Drill Hole Set

S 81°35'00" W 94.75'

Ex. R/W

CHAPEL ST. ~ 33'

SCALE: 1" = 30'




GRAPHIC SCALE

BOUNDARY EXHIBIT OF A 0.410 ACRE TRACT
AT THE SOUTHWEST CORNER OF
E. STATE ST. AND SIXTH AVE.

COLUMBUS, OHIO

BASIS OF BEARINGS: The South Line of State Street being assumed at N 81° 35' 00" E. All other bearings are based upon this meridian.

December 12, 2001

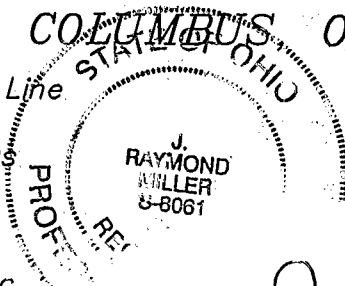

By *Jay R. Miller*
Jay R. Miller ~ Ohio Surveyor No. 8061



C.F. Bird & R.J. Bull, Inc.
2875 W. Dublin-Granville Rd.
Columbus, Ohio 43235

Exhibits\Grant MOB Bndy.dwg