THE JENNINGS - LAWRENCE CO.
CIVIL AND MUNICIPAL ENGINEERS
COLUMBUS, OHIO

4.252 ACRES, PART OF LOT 33, M.L. SULLIVANT'S SUB. OF FARMING LANDS COLUMBUS, OHIO FOR MR. THEODORE HORST

Scale 1" = 80'

Feb. 18, 1955

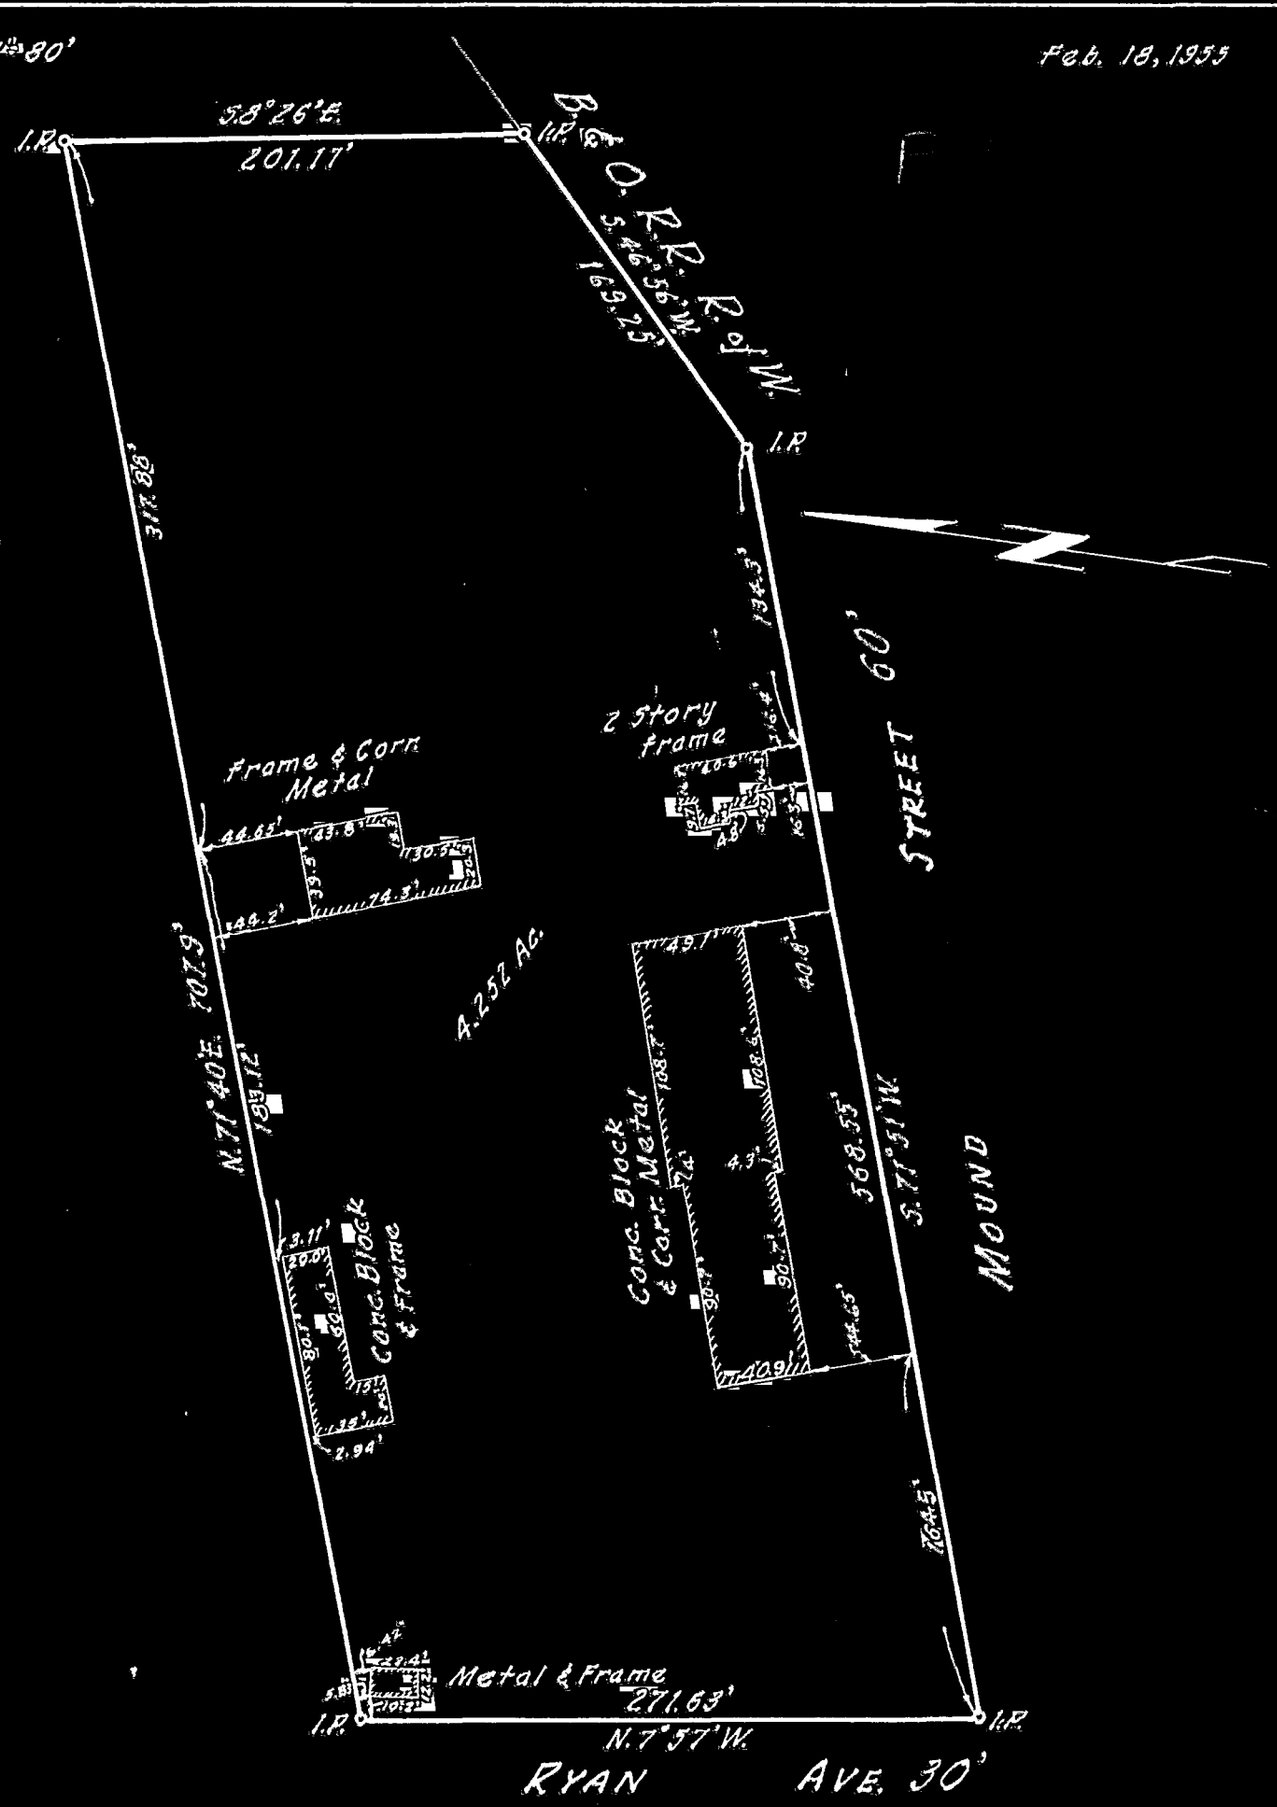

We hereby certify that the foregoing drawing was prepared from an actual survey of the premises and correctly shows the location of the boundaries, improvements and joint drives if any.

THE JENNINGS - LAWRENCE CO.

By _____

REGISTERED SURVEYOR

Surv'd	Drawn	Checked
J.L.W.	R.S.N.	C.W.J.

J-6490