

MYERS SURVEYING CO.


2740 East Main Street, Columbus 43209 (Bexley), Ohio

Plat of survey of a 3.000 Acre tract and a 9.796 Acre tract, together comprising all of the Netcare Corporation 12.796 Acre tract (O.R.V. 9563 I-07, Parcel Two), located in V.M.S. Nos. 1393 and 2668, City of Columbus, Franklin County, Ohio.

FRANKLIN COUNTY MENTAL HEALTH BOARD and/or NETCARE CORPORATION

P.B. Page
Scale 1" = 150'


Franklin Co. Rec. Office
10 - 23 - '89

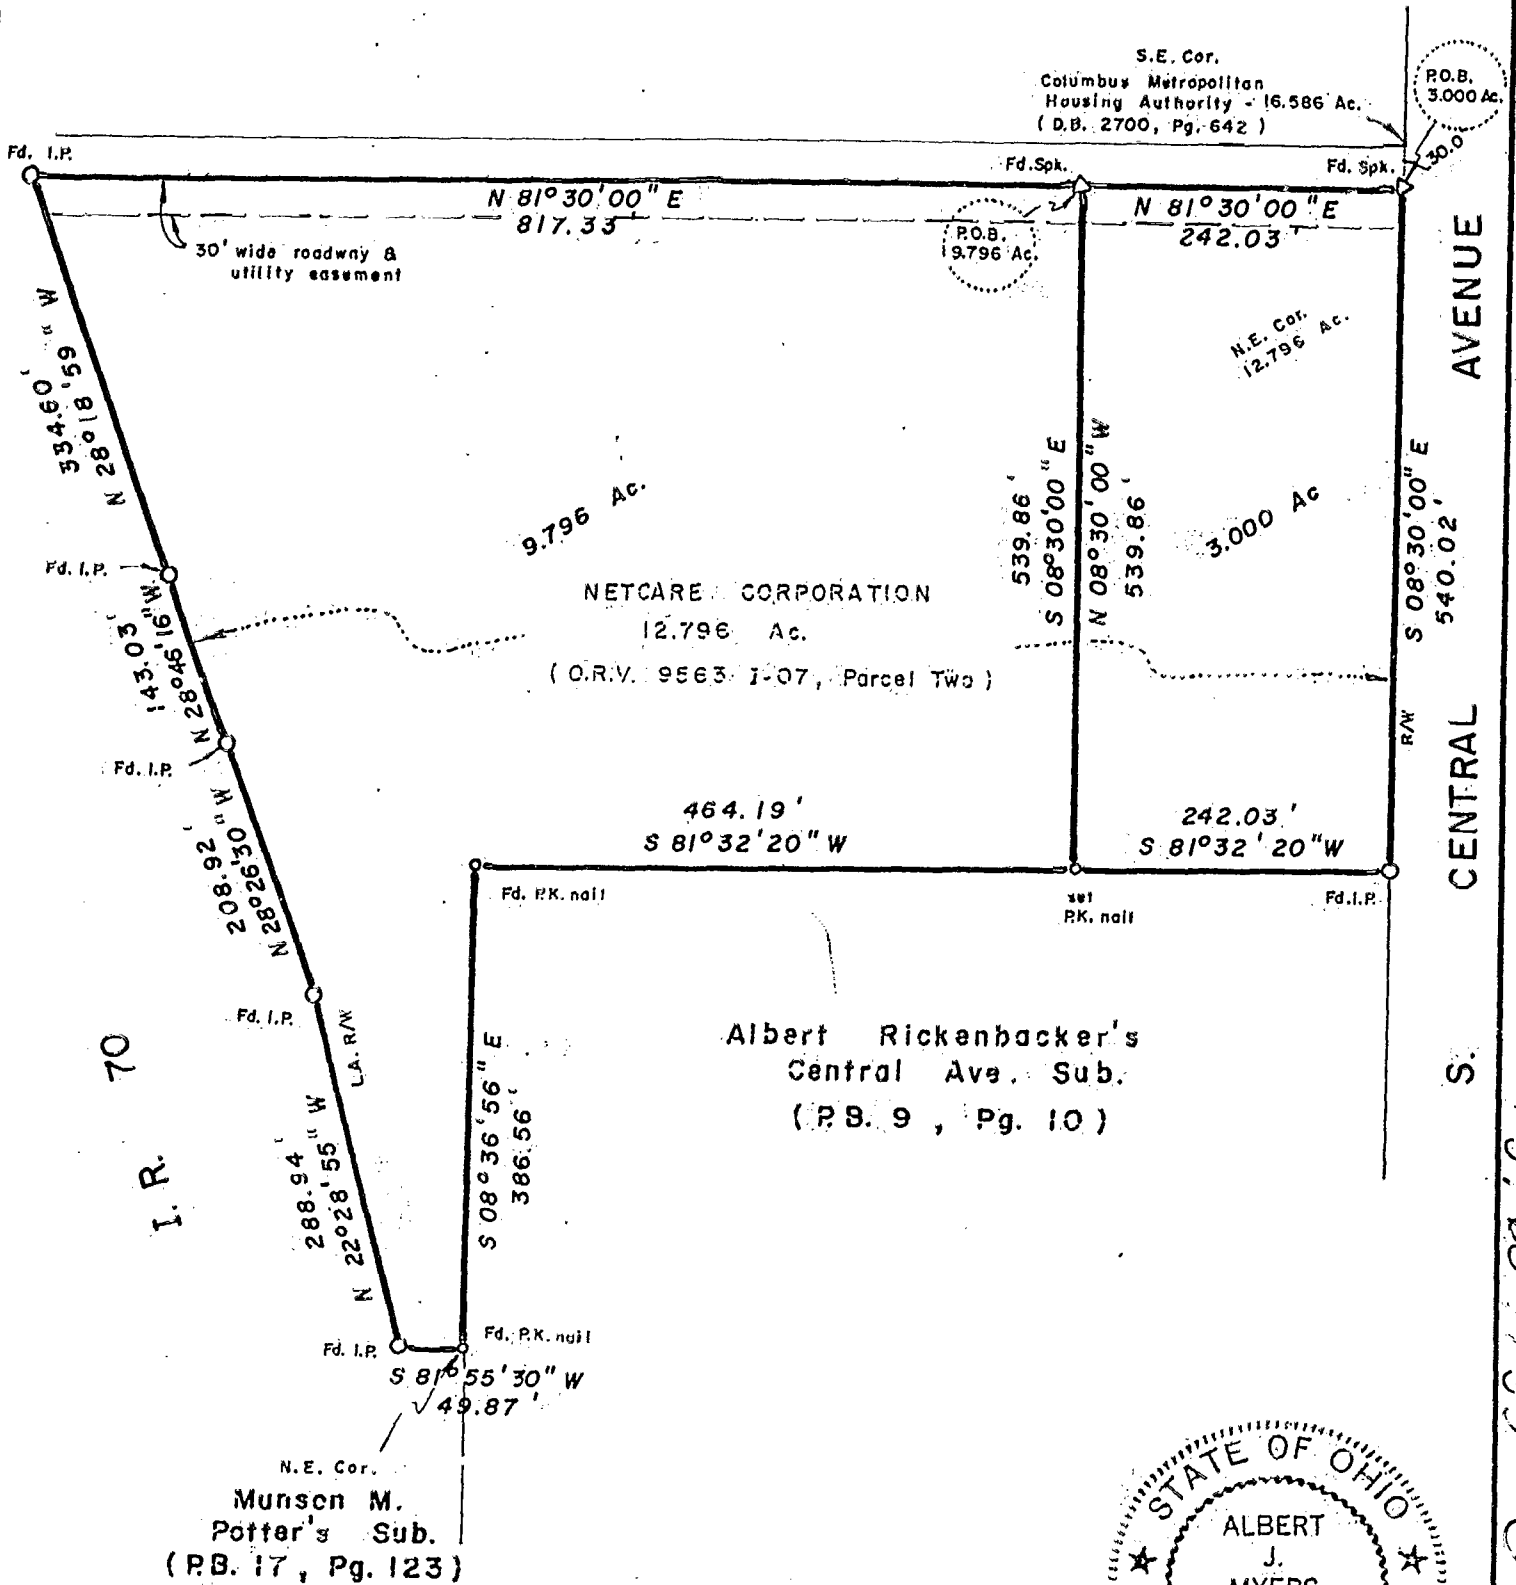

We hereby certify that the foregoing plat was prepared from an actual survey of the premises in October, 1989 and is correct to the best of our knowledge. Basis of bearings is O.R.V. 9563 I-07.

MYERS SURVEYING CO.

BY Albert J. Myers
Registered Surveyor

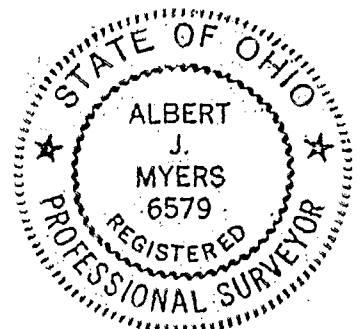

7-17-90 6012918