

DODSON SURVEYING COMPANY

182107100

Columbus, Ohio

Survey of Lot No. 134 of B.F. Martin's Western Addition
City of Columbus, Franklin County, Ohio

For: David E. & Willie Marie Evans, owners



915 W. Rich St., Cols. Ohio 43223

- o = Iron Pin Found
- = Iron Pin Set, 30" x 3/4"
- (40') = Indicates Plot dimension

F-20

Basis of Bearings is $N^{90^{\circ}00'}E$ assumed
along the centerline of W. Rich St.

Area of lot No. 134 (per Survey) = 6427 sq. ft. or 0.148 Ac.

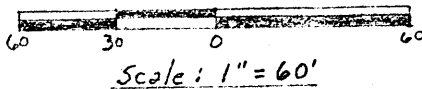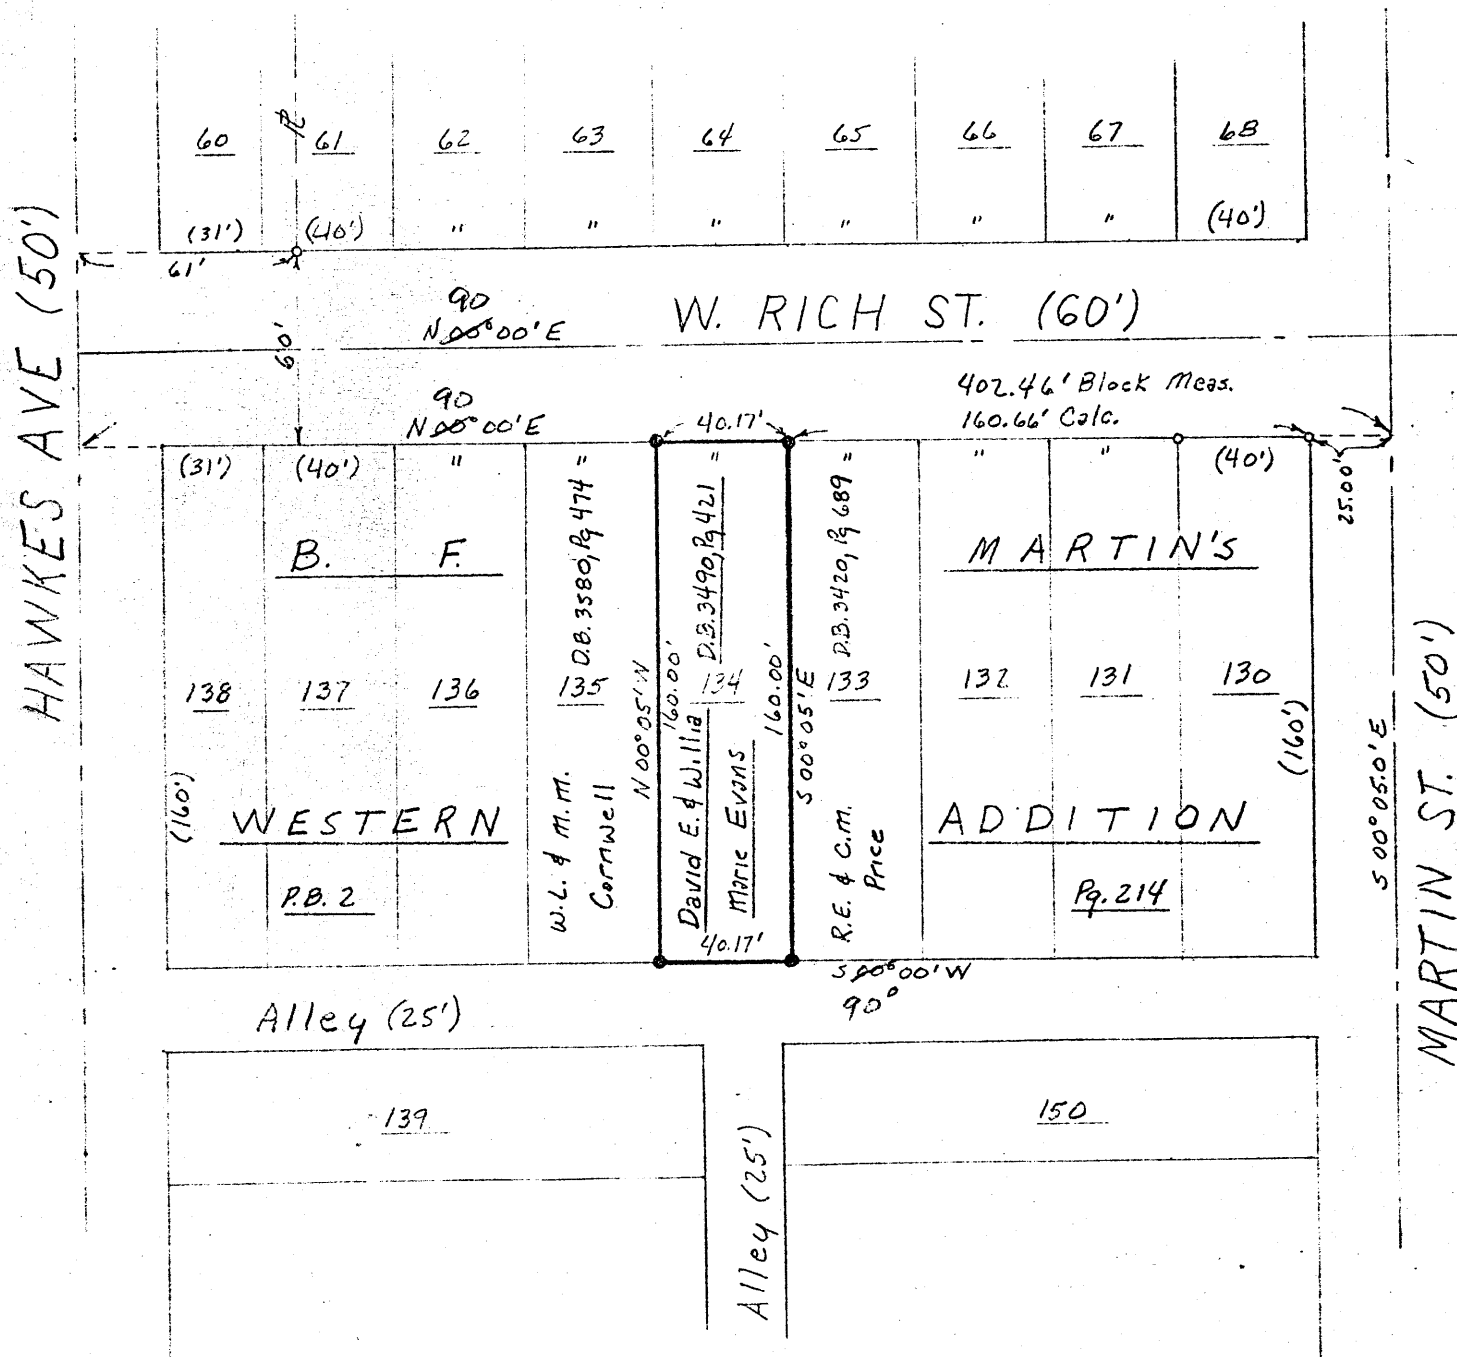

We hereby certify that the foregoing plat was prepared
from an actual survey of the premises.

by: Walter A. Dodson 17 May 78

Walter A. Dodson, P.S., No. 6446, Ohio

Rev. 12-2-81 (Orig. W. Rich = 90°)

