


c/223

18285 1076


Third Street (82.5')

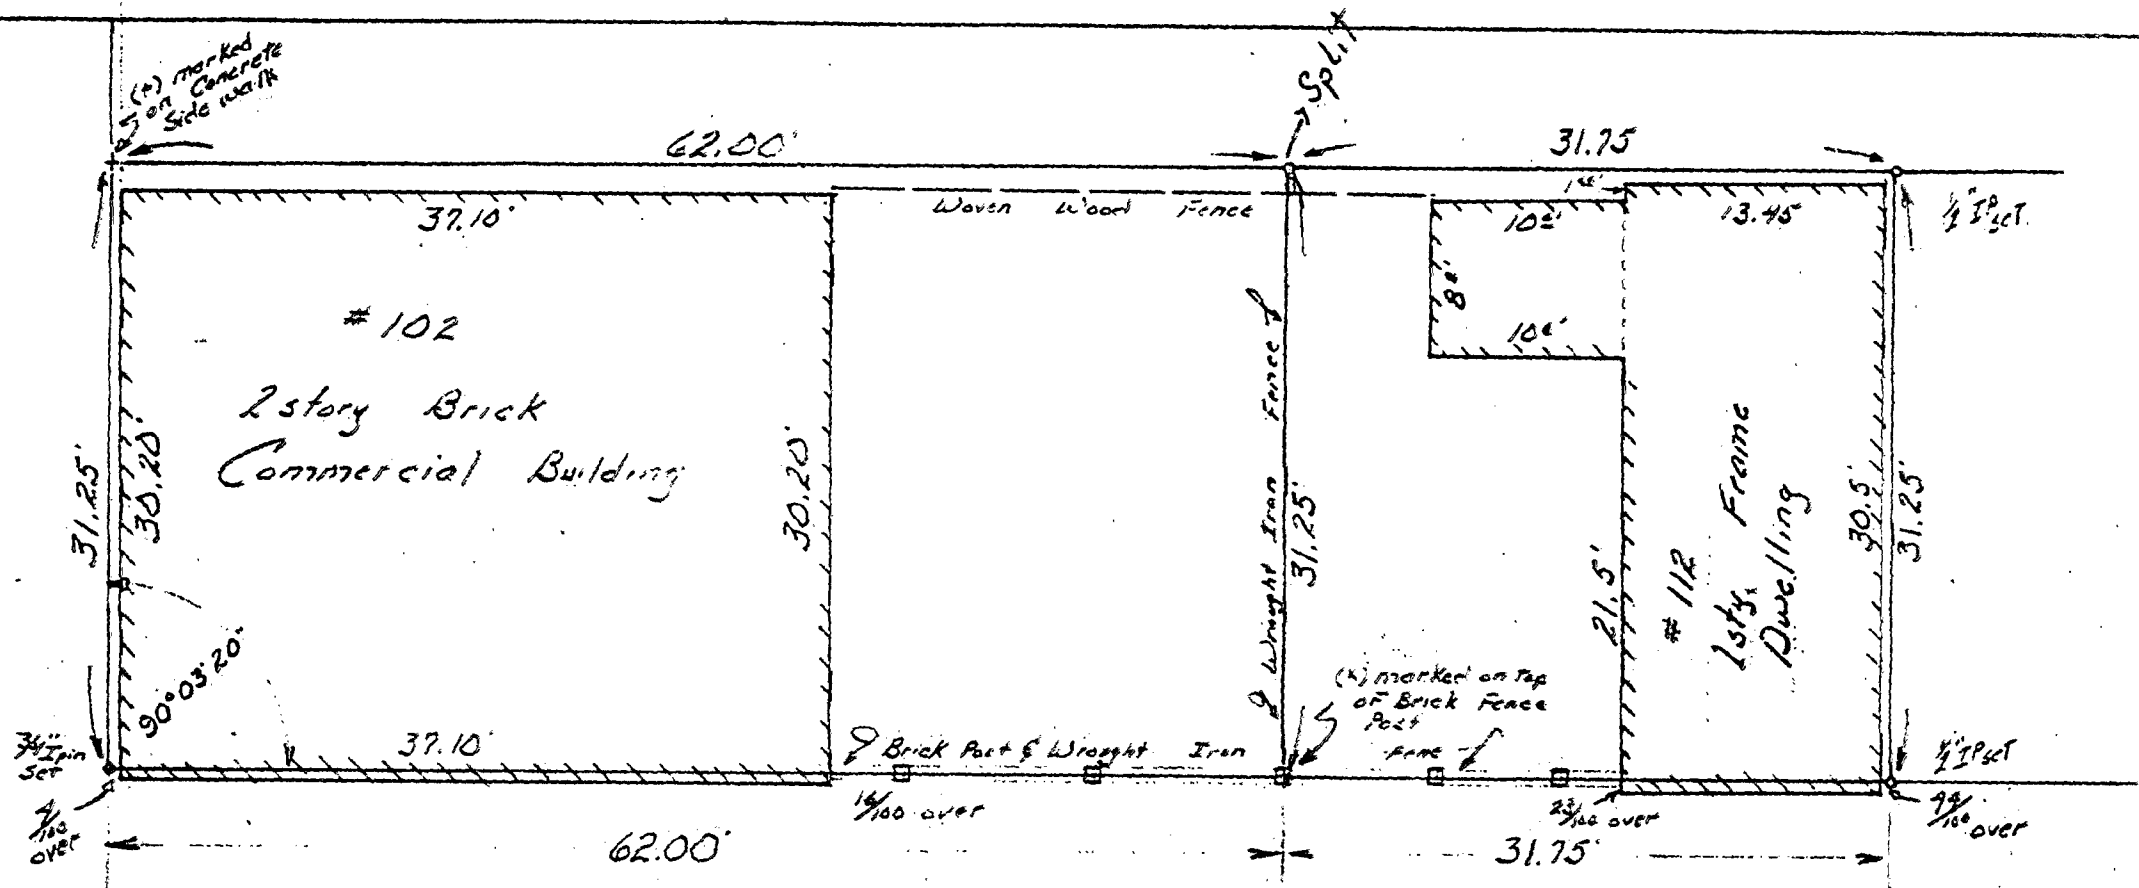

Whittier St. (60')


Survey and Division of  
 the West 1/2 of the South 1/2 Lot # 95  
 in C.F. Jaeger's 12<sup>th</sup> Addn. in the  
 City of Columbus, Franklin Co.,  
 Ohio: for

John W. Moore & H.S. Bigelow

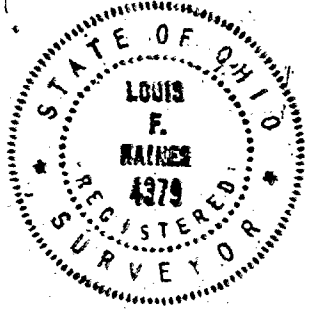

**Louis F Haines**

354 Kessler Street  
 Groveport, Ohio 43125  
 Phone 837-2181

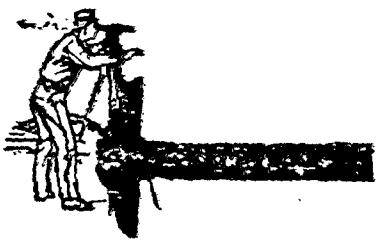

HEREBY CERTIFY THE PLAT SHOWN HEREON  
 IS CORRECT AS SURVEYED BY US.  
 DATE: September 3, 1965  
 SIGNED: Louis F. Haines