



18283 1075

A Boundary Survey prepared for and certified to:
Mr. R.D. Jones

Legal Description: Situated in Ohio, County of Franklin, City of Columbus, Being Lot 43 C.F. Jaeger's 5th Addition, Plat Book 1, Page 196

Applicant:
 Posted Address: 797 City Park Ave./794-798 S. Pearl St., Columbus, Ohio

S. PEARL ST. 33'

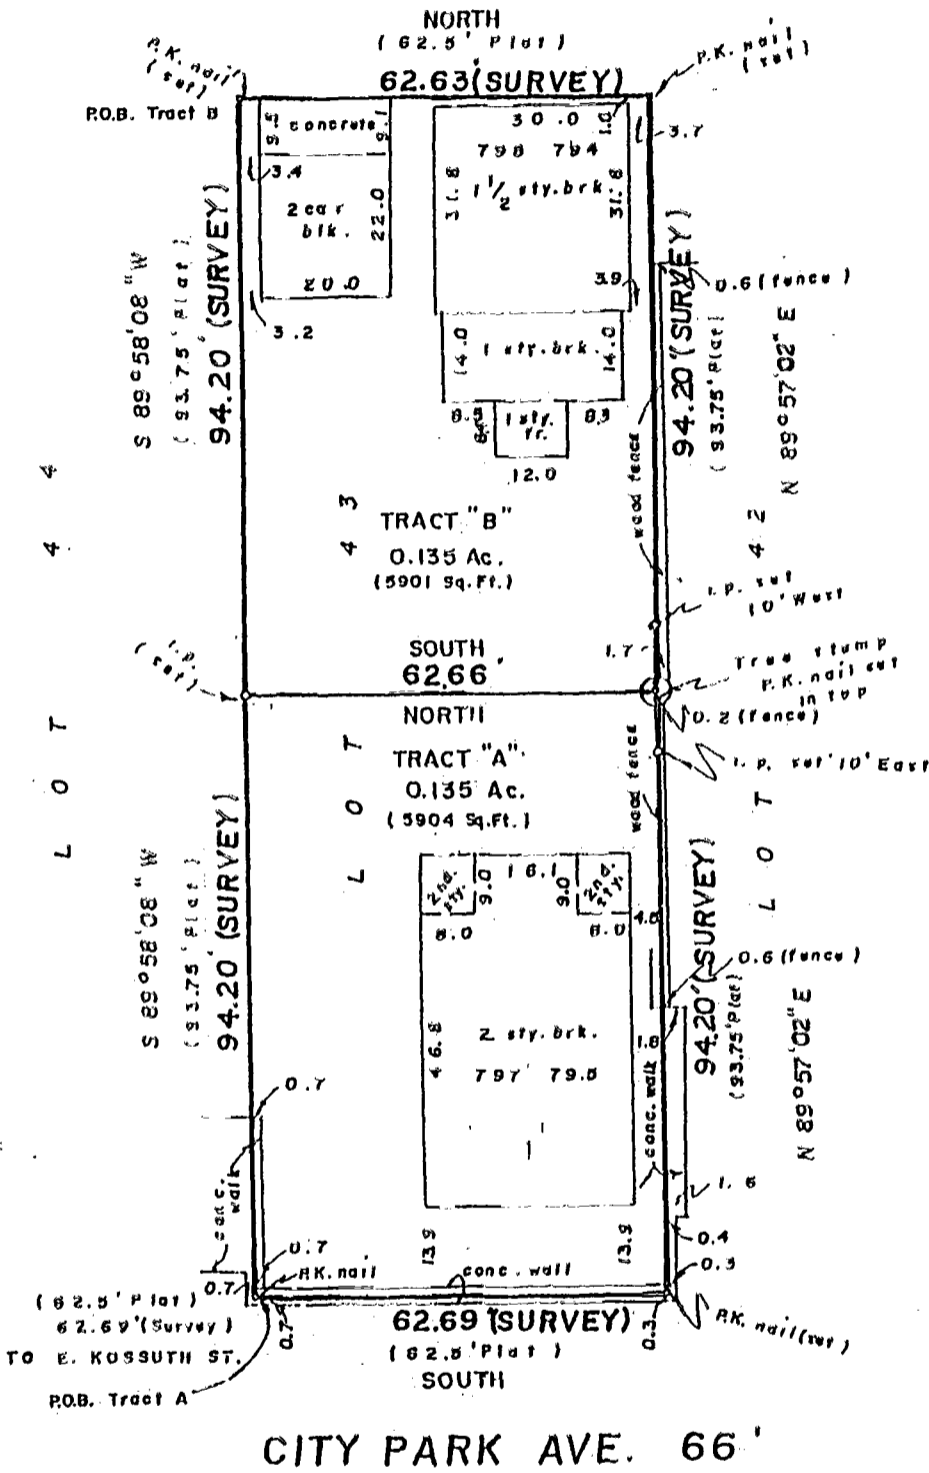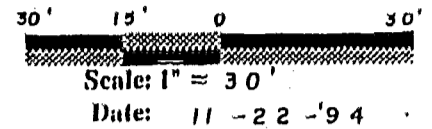

We hereby certify that the foregoing Boundary Survey was prepared from actual field measurements in accordance with Chapter 4733-37 Ohio Administrative Code. Iron pins set are 30"x1" O.D. with an orange plastic plug inscribed "P.S. 6579", unless otherwise noted. Basis of bearing is the centerline of City Park Ave. as NORTH.

Myers Surveying Co., Inc.

By Albert J. Myers
 Professional Surveyor

| | | | | | |
|-------------------------------|------|--------------|------------|------|-----|
| Myers Order No. - 11-11/10/94 | Rec. | Field (R.D.) | DWG (J.T.) | Ltr. | ck. |
|-------------------------------|------|--------------|------------|------|-----|

18283