

182857100

MYERS SURVEYING CO.

2740 East Main Street, Columbus 43209 (Wexley), Ohio


PART OF LOT 703 JOHN MCGOWAN'S ADDN. COLUMBUS, OHIO

FOR

MR. BRIAN BARRETT


D.B. "G" Page 70

Franklin Co. Rec. Office

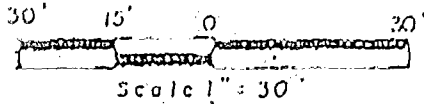


7.6. '90

Rev. 7-17-'90 (legal & l.p.'s)

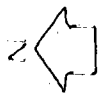

CITY PARK AVE, 66'

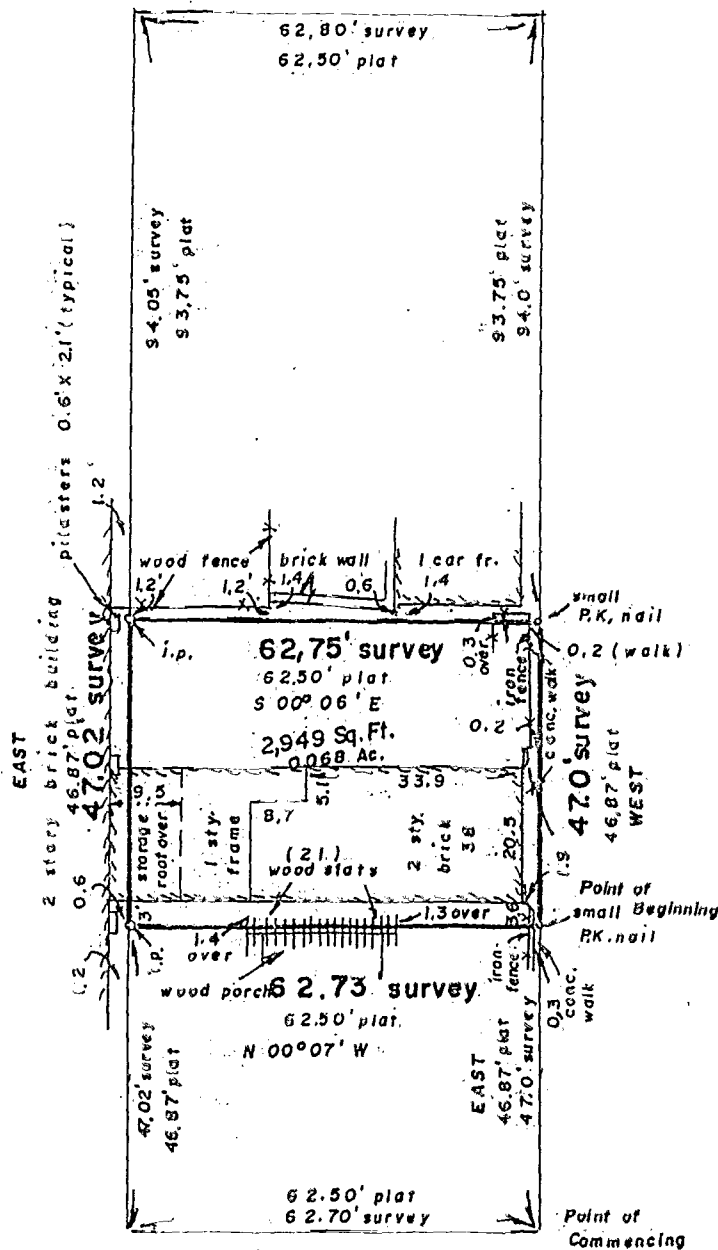


E. BECK ST. 33'

S. PEARL ST. 33'

BASIS of BEARINGS -
North line of E. Beck St.
assumed EAST.

We hereby certify that the foregoing plat was prepared from an actual survey of the premises. Iron pins set are 30" x 1" O.D. with an orange plastic caps inscribed "P.S. 6579".

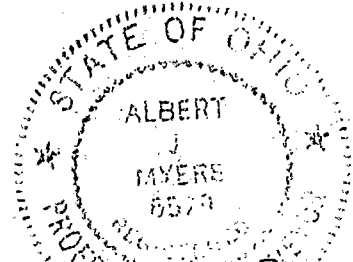

MYERS SURVEYING CO.

BY *Albert Myers*
Registered Surveyor