



# Myers Surveying Company, Inc.

2740 East Main Street, Columbus 43209 (Bexley), Ohio  
614-235-8677 FAX: 614-235-4559

A Boundary Survey prepared for and certified to:  
Old Republic National Title Insurance Company

Legal Description: Situated in Ohio, County of Franklin, City of Columbus, Being Lot 728 and the North Half of Lot 727 John McGowans Addition, Deed Book "G", Page 70  
Applicant: Salvatore  
Posted Address: S Third St./E Blenkner St./S Lazelle St., Columbus, Ohio

20' 10' 0' 20'  
Scale: 1" = 20'  
Date: 11 - 10 - '95  
Rev 11 - 30 - '95 (prop. splits)  
Rev 1 - 10 - '96 (splits)

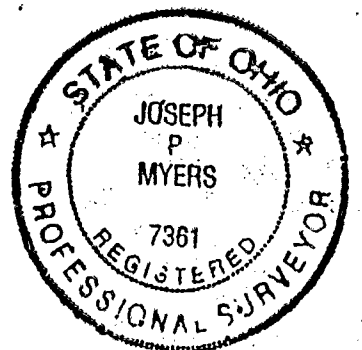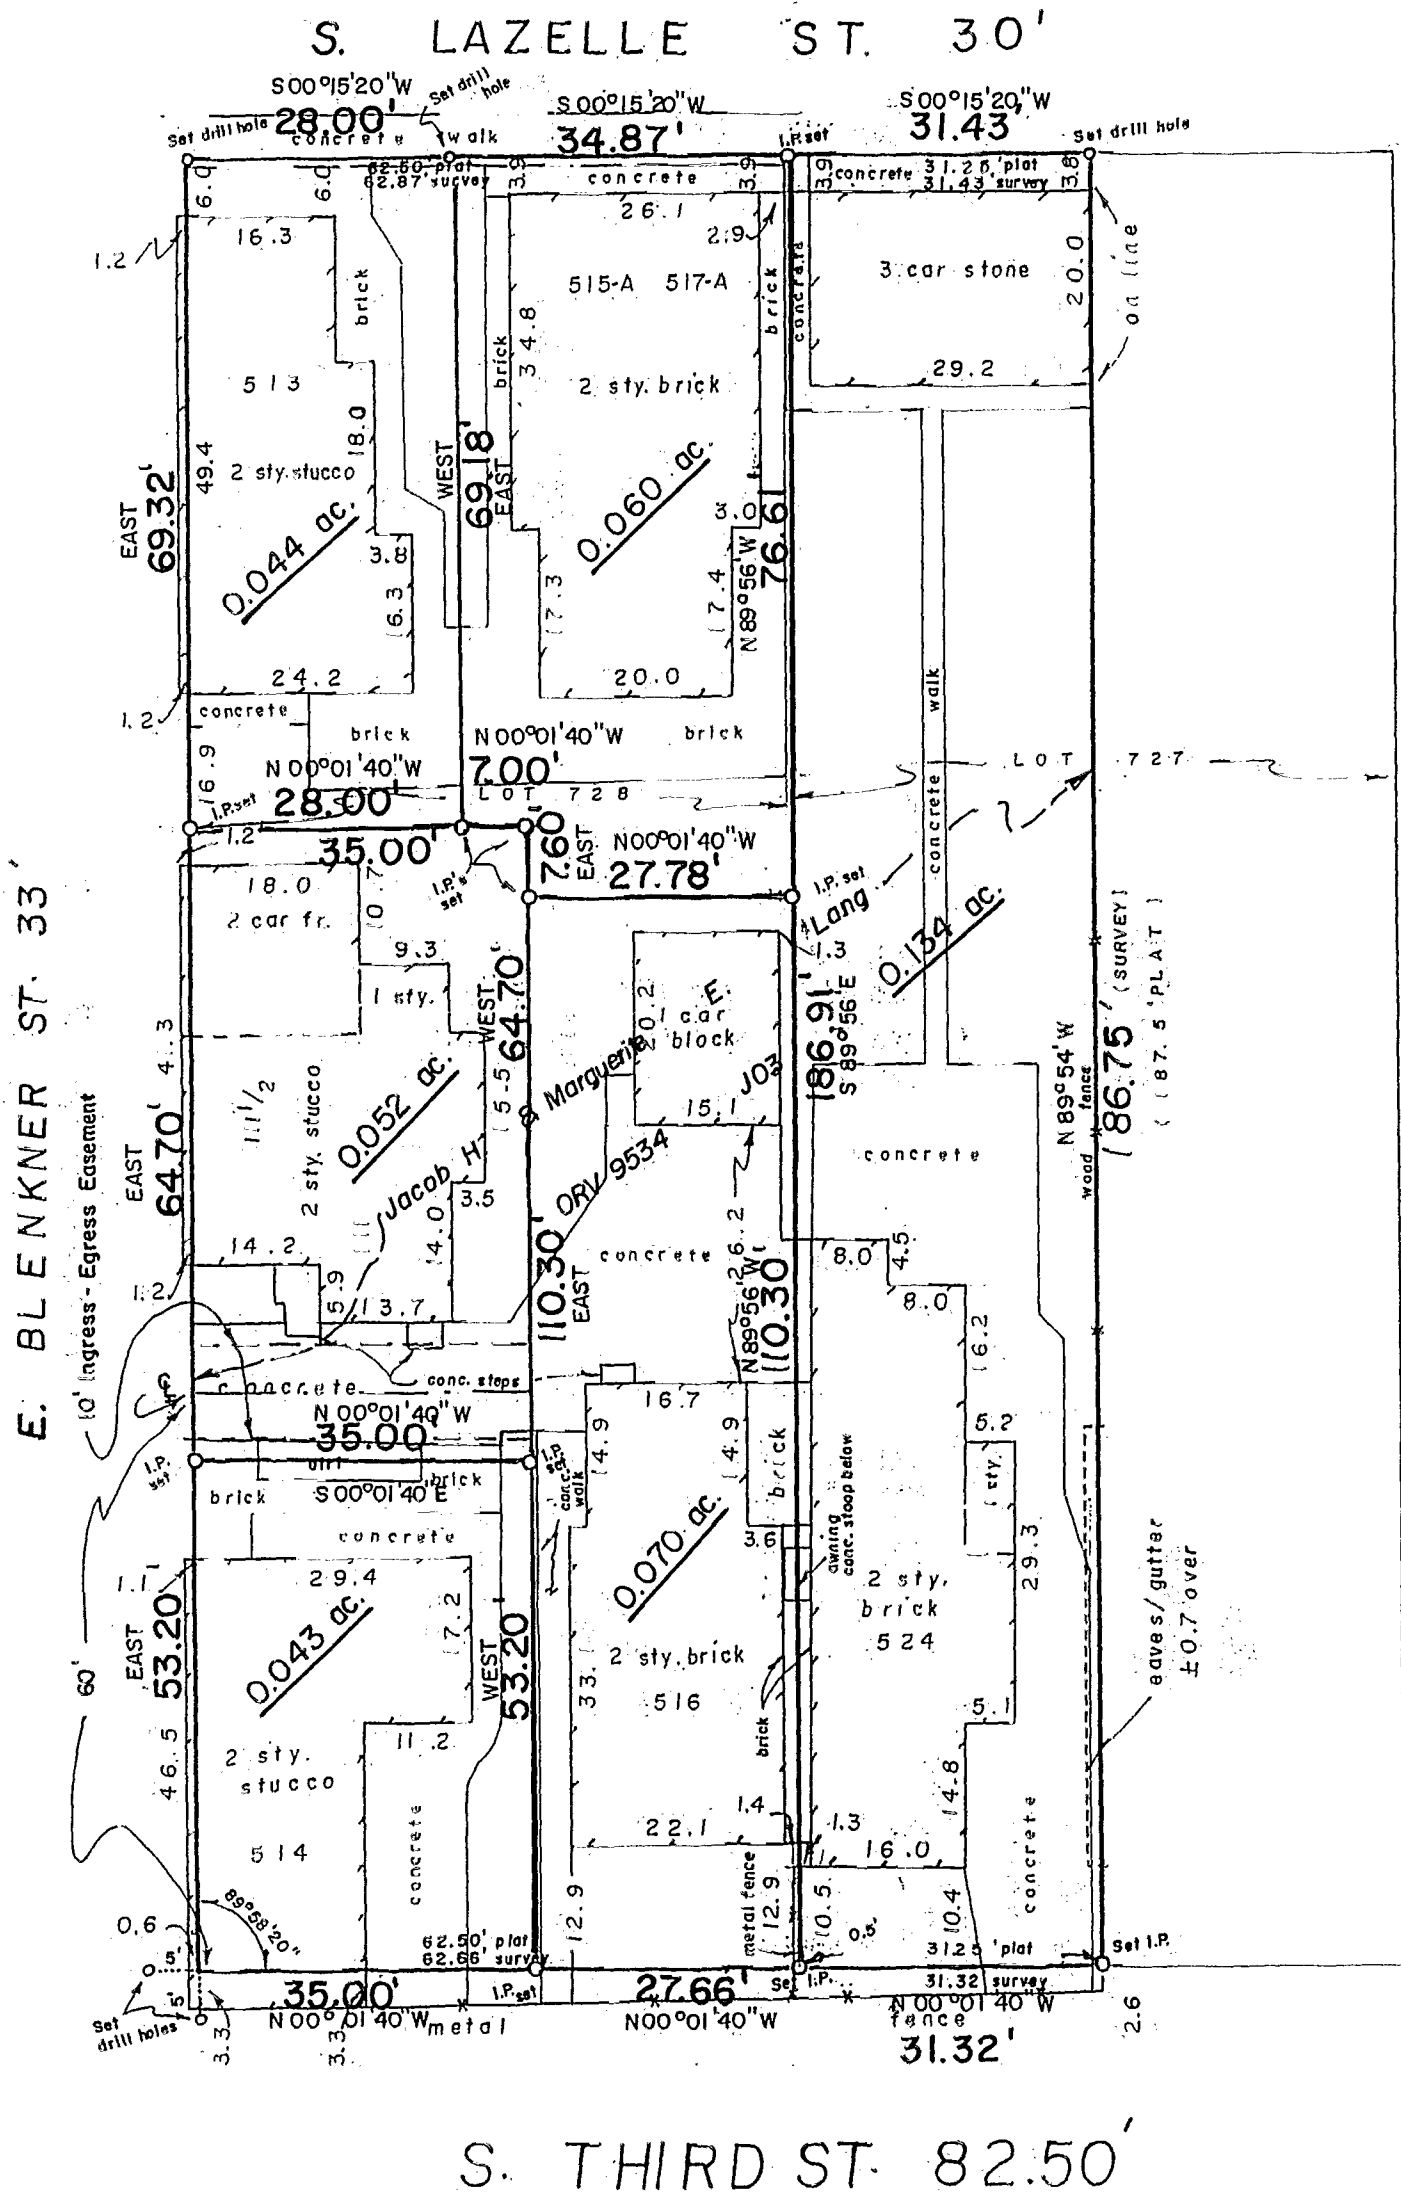

We hereby certify that the foregoing Boundary Survey was prepared from actual field measurements in accordance with Chapter 4733-37 Ohio Administrative Code. Iron pins set are 30"x1" O.D. with an orange plastic plug inscribed "P.S. 6579", unless otherwise noted. Basis of bearing is northerly line of Lot 728 assumed EAST.

Myers Surveying Co., Inc.

By *Joseph P. Myers*  
Professional Surveyor

Myers Order No. - 26-11/03/95 | Rec. | Field JLW | DWG JPM | Ltr. | Ck.

MARION 82-857-100