

182857075


MYERS SURVEYING Co.

2740 East Main Street, Columbus 43209 (Bexley), Ohio



PART OF LOTS 1 & 2 FREDERICK MICHEL'S SUB. COLUMBUS, OHIO
FOR
AMERICAN REALTY TITLE ASSUR. CO.

P.B. 3 Page 114
Scale 1" = 25'

Franklin Co. Rec. Office
12-9-'89
Rev. 12-20-'89

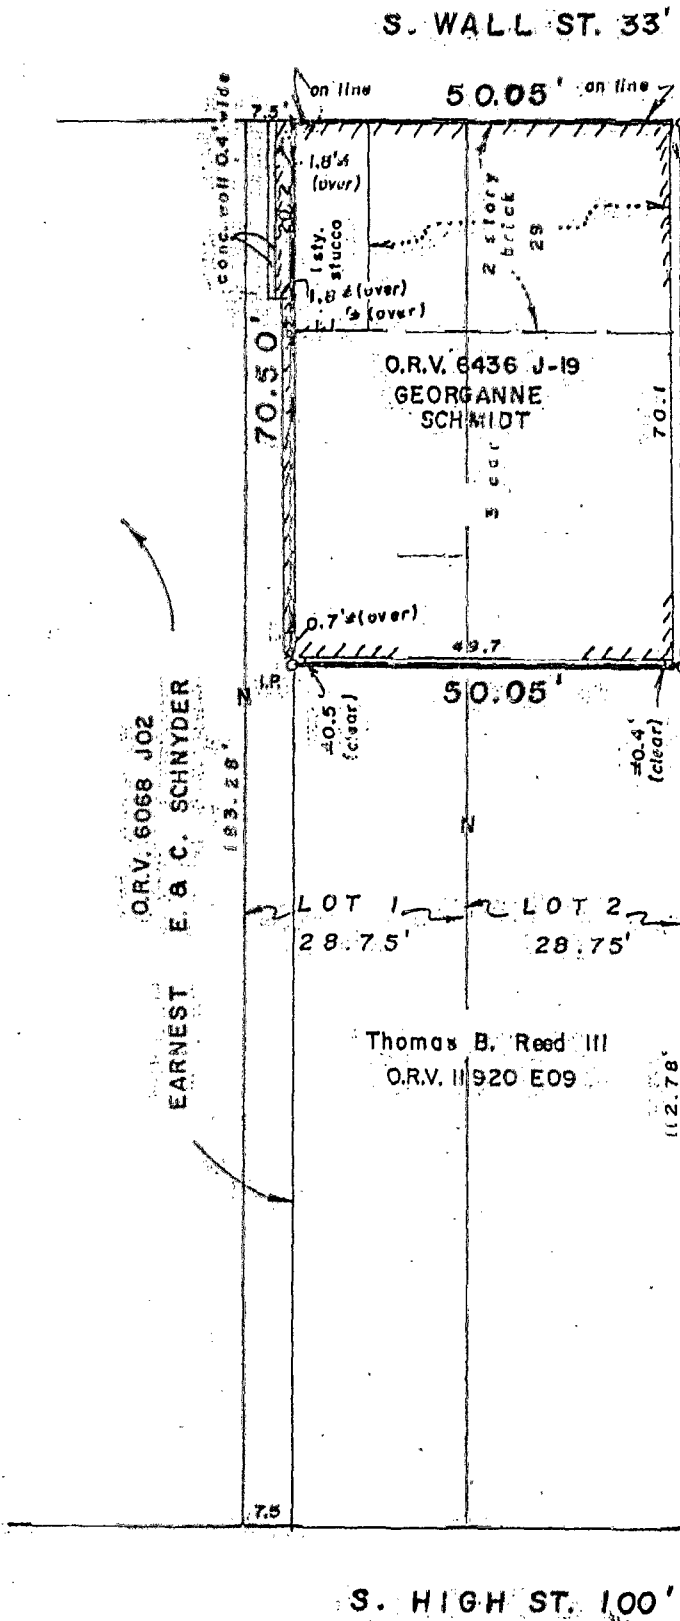

FREDERICK ST. 60'

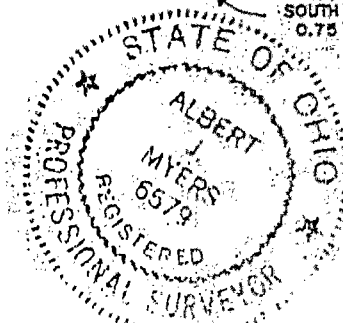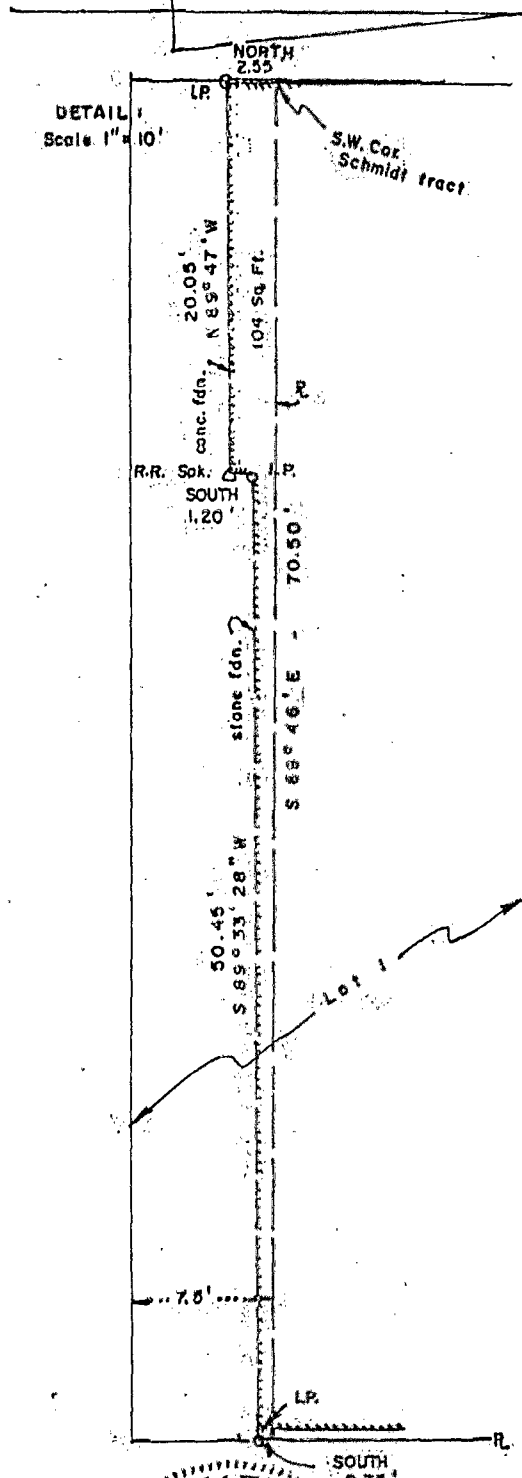

We hereby certify the foregoing plat was prepared from a survey of the premises in December 1989 and is correct to the best of our knowledge. Basis of bearings is the east line of South Wall Street assumed North. Set iron pipes are 30" x 1" O.D. with orange plastic plugs inscribed "P.S. 16579".

MYERS SURVEYING CO.

BY Albert Myers
Registered Surveyor

FERRIS 33-12-4-89