JERRY A. MALOTT SURVEYING Co.

6810 East Main Street ~ Suite 101, Columbus, Ohio 43068 (614) 577-0957

FOR: 18285 7100 **B & J INVESTMENT CO.**

BOUNDARY SURVEY

APRIL 27, 1994 #11079

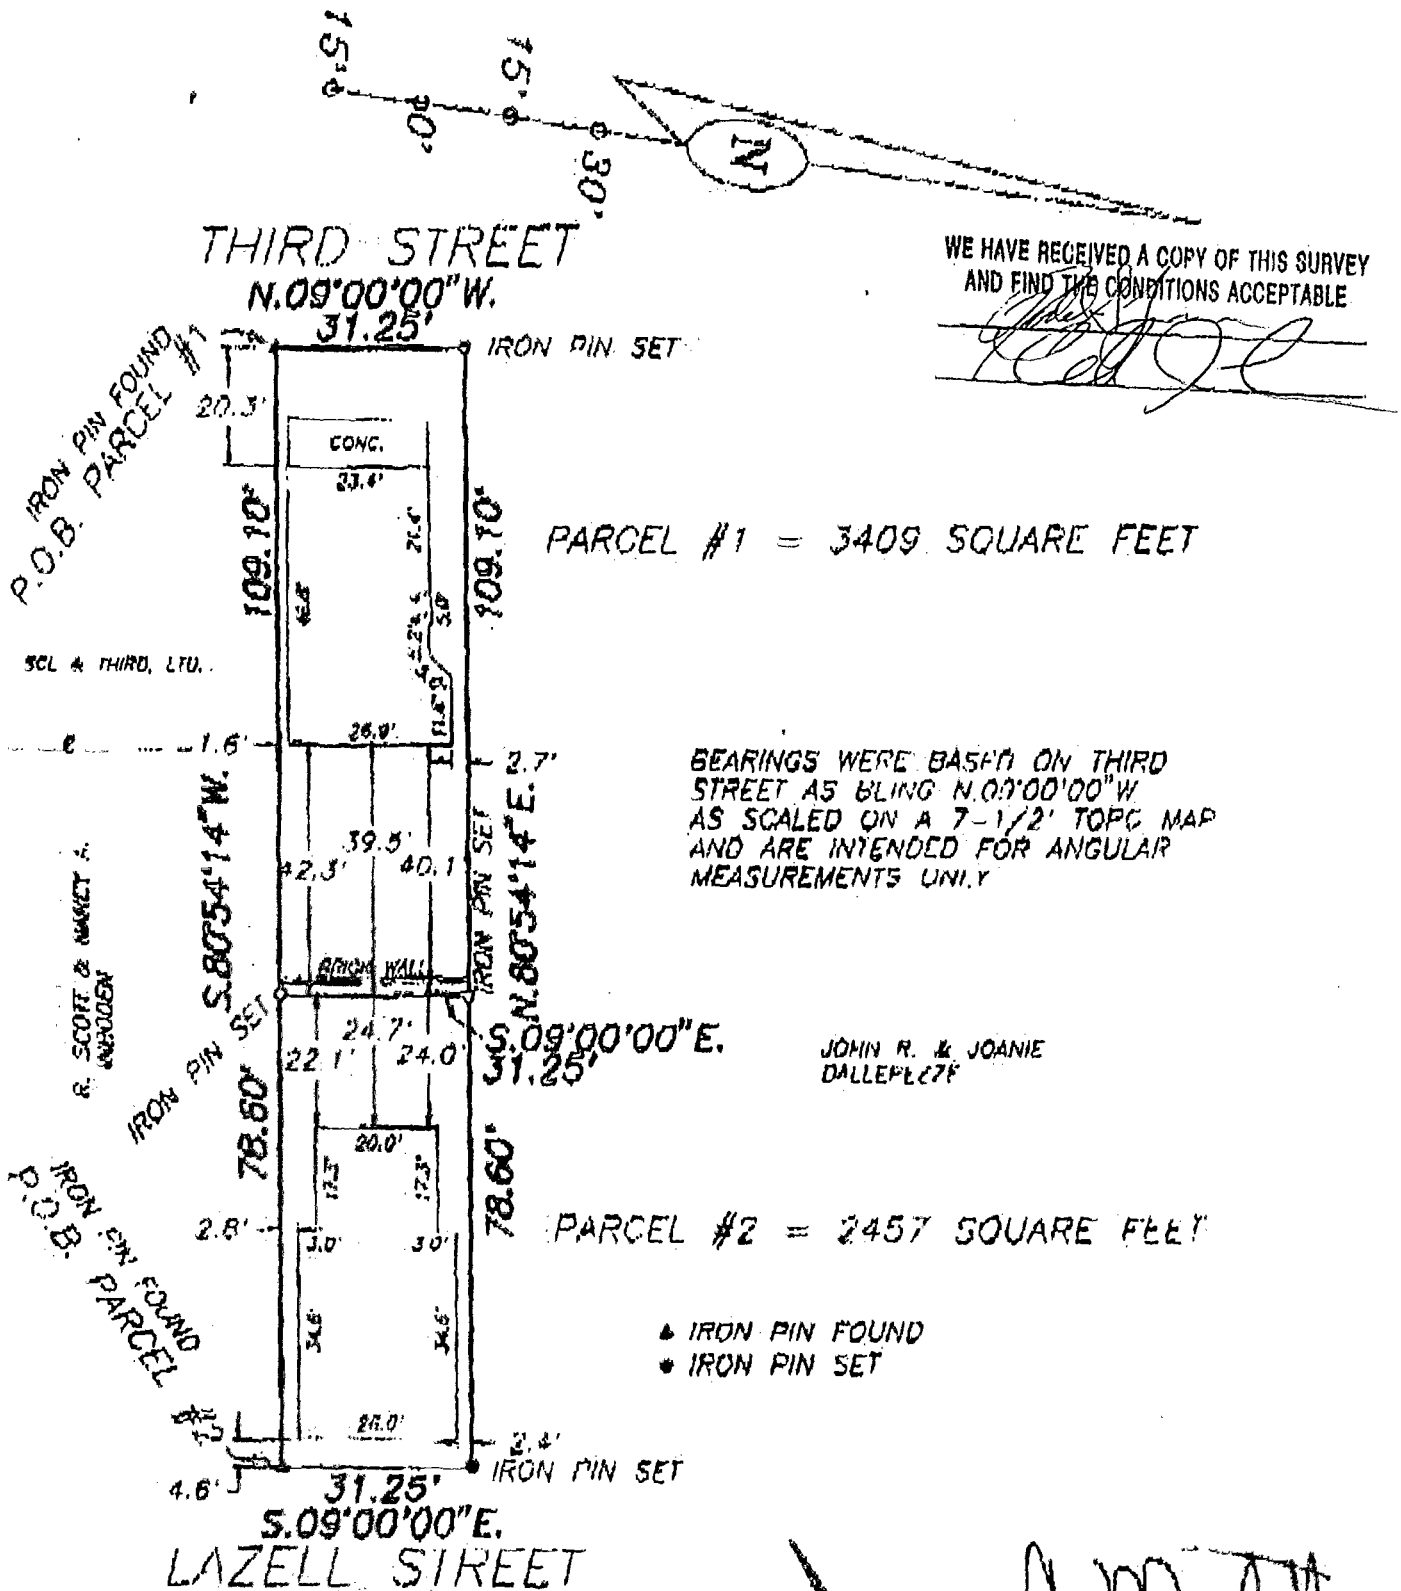

WE HAVE RECEIVED A COPY OF THIS SURVEY AND FIND THE CONDITIONS ACCEPTABLE

BEARINGS WERE BASED ON THIRD STREET AS BEING N.09°00'00"W AS SCALED ON A 7-1/2' TOPO MAP AND ARE INTENDED FOR ANGULAR MEASUREMENTS ONLY

▲ IRON PIN FOUND
● IRON PIN SET

BY Jerry A. Malott
Professional Surveyor
JERRY A. MALOTT

SCALE 1" = 30' DATE 04-27-94

LOCATION Being The South Half Of Lot #2 Block #1 McGowans Add. P.B. 6, Pg. 70
State Of Ohio, County Of Franklin, Deed Reference O.R. 22485 308