


18285 7075

J 24

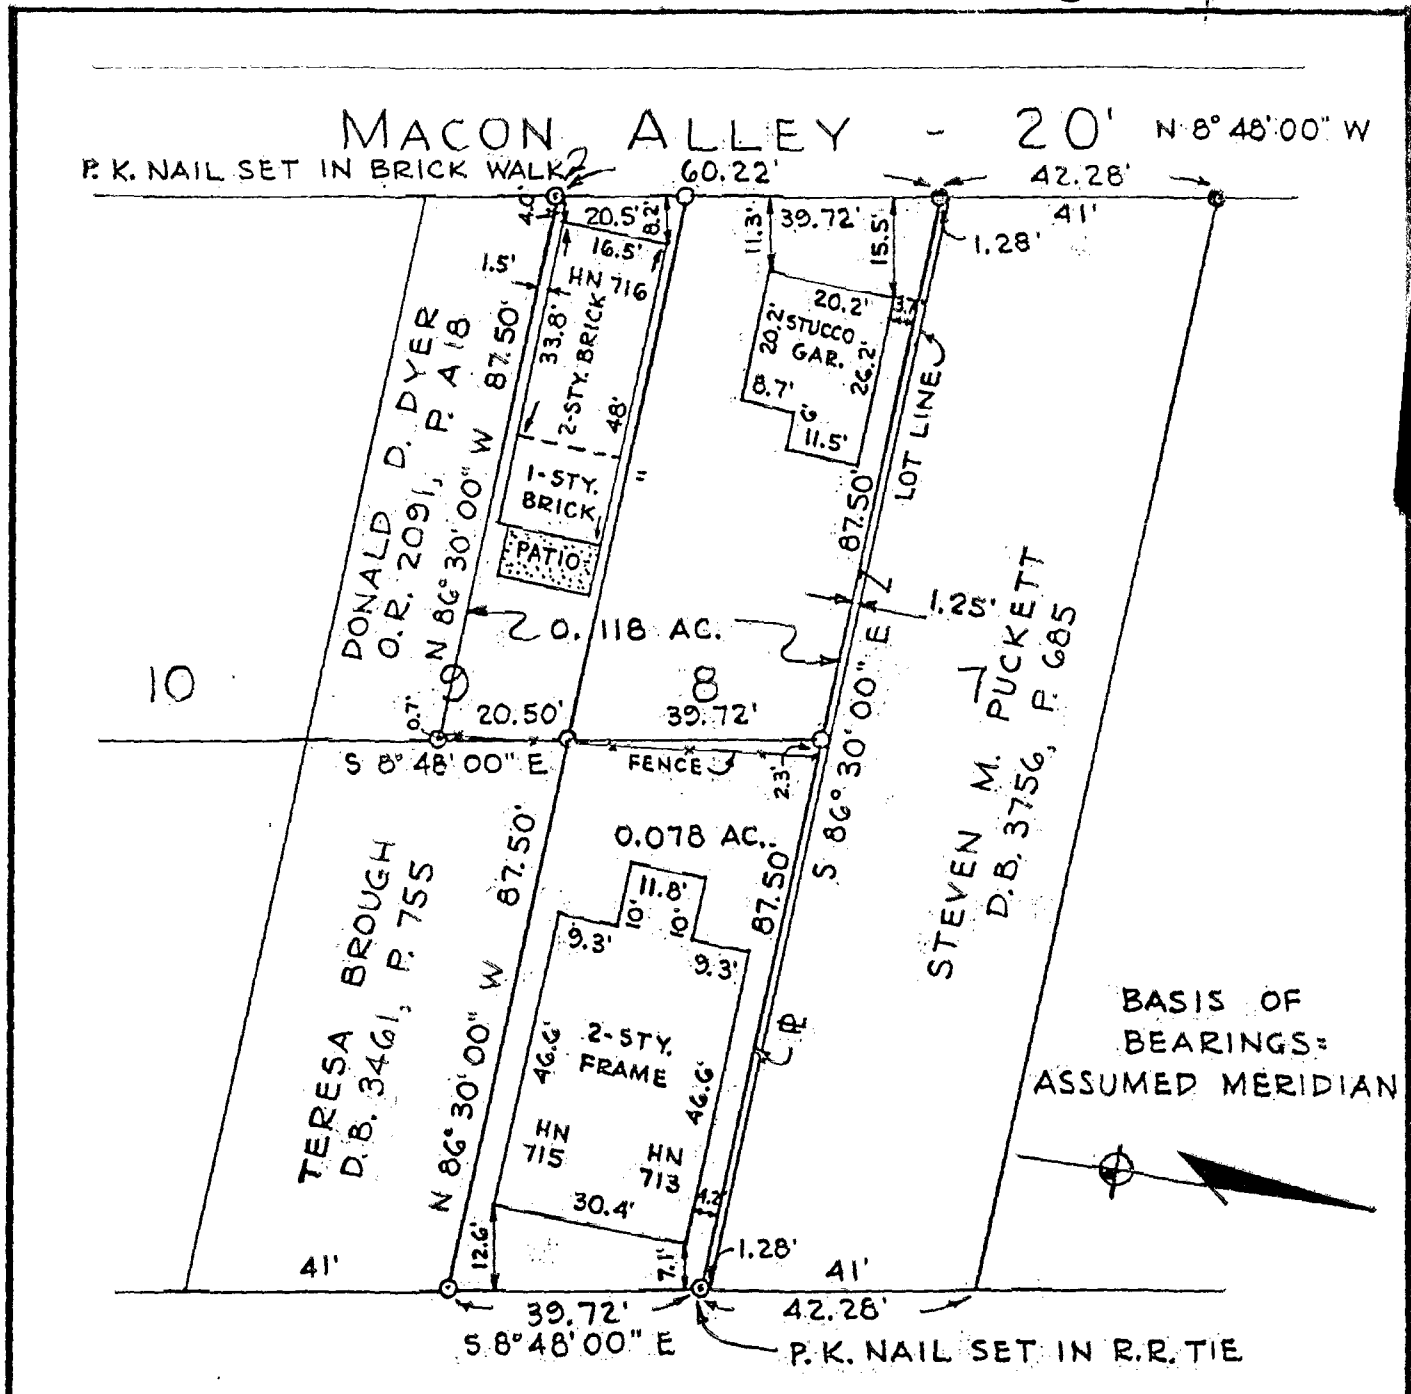

S. FIFTH ST. - 50'

SURVEY OF PARTS OF LOTS 8 & 9, B. F. STAGE'S SUBD. (P.B. 1, P. 399) AT 716 MACON ALLEY & 713-715 S. 5TH ST. COLUMBUS, OHIO, FOR MR. & MRS. A. MICHAEL BURKEY

SCALE: 1" = 30'

SEPT. 12, 1986

C. F. BIRD & R. J. BULL, LTD.
2875 W. DUBLIN-GRANVILLE RD.
WORTHINGTON, OHIO

Richard J. Bull

#4723

- - 3/4" I.D. IRON PIPE FOUND
- - 3/4" I.D. IRON PIPE SET

86-286

DJB