Myers Surveying Company, Inc.

2740 East Main Street, Columbus 43209 (Bexley), Ohio
614-235-8677 FAX: 614-235-4559

A Boundary Survey prepared for and certified to:
Mr. Thomas Kilbane

Legal Description: Situated in Ohio, County of Franklin, City of Columbus, Being Part of Lot 36 C.F. Jaeger's 3rd Addition, Deed Book 41, Page 280

Applicant:

Posted Address: 22-24 W. Columbus Street, Columbus, Ohio

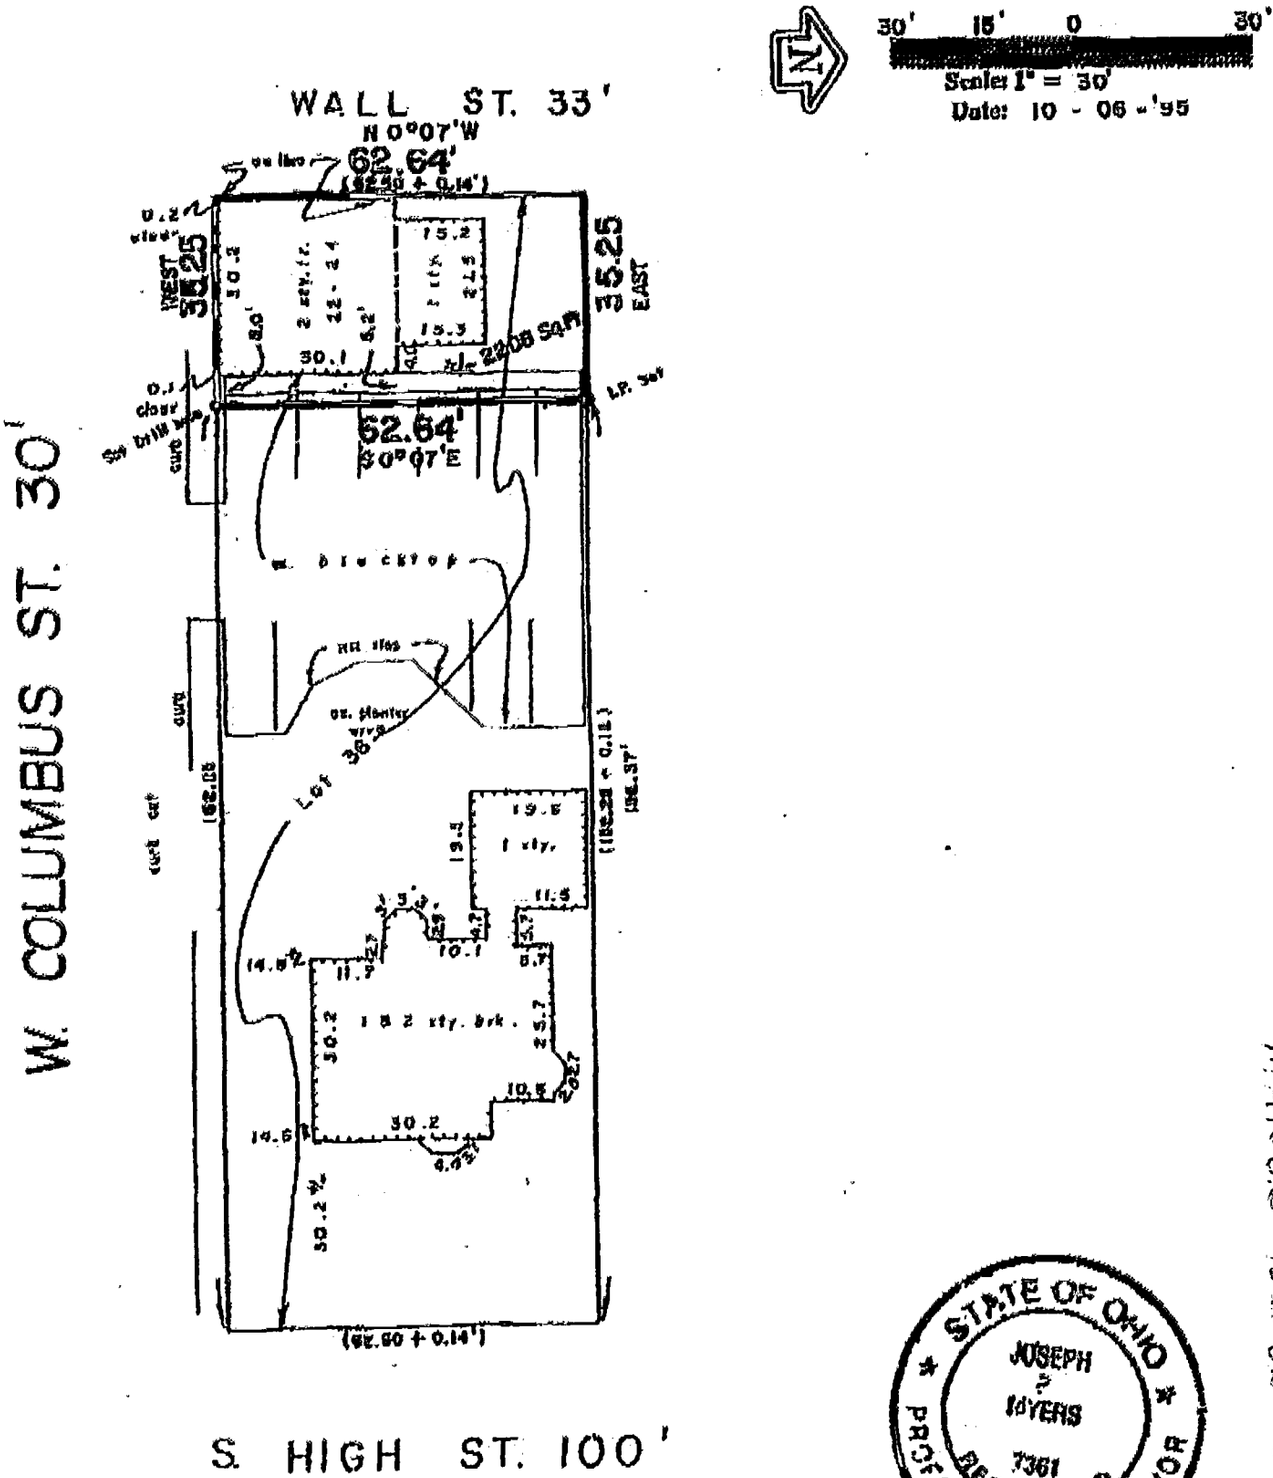

We hereby certify that the foregoing Boundary Survey was prepared from actual field measurements in accordance with Chapter 4733-37 Ohio Administrative Code. Iron pins set are 30"x1" O.D. with an orange plastic plug inscribed "P.S. 6579", unless otherwise noted. Basis of bearing is the northerly line of W. Columbus St. assumed WEST.

Myers Surveying Co., Inc.

By: Joseph P. Myers
Professional Surveyor

STATE OF OHIO * JOSEPH P. MYERS 7361 REGISTERED PROFESSIONAL SURVEYOR *

Myers Order No. - 12-06/07/95	Rec.	Field	DWG	Ltr.	Ck.