5285 7169


PART OF LOT 1, CHARLES MINSTER'S SUB. COLUMBUS, OHIO

FOR

Town Homes, Inc.

P.B. 1 Page 328
Scale 1"=20'

Franklin Co. Rec. Office
12 · 4 · 70

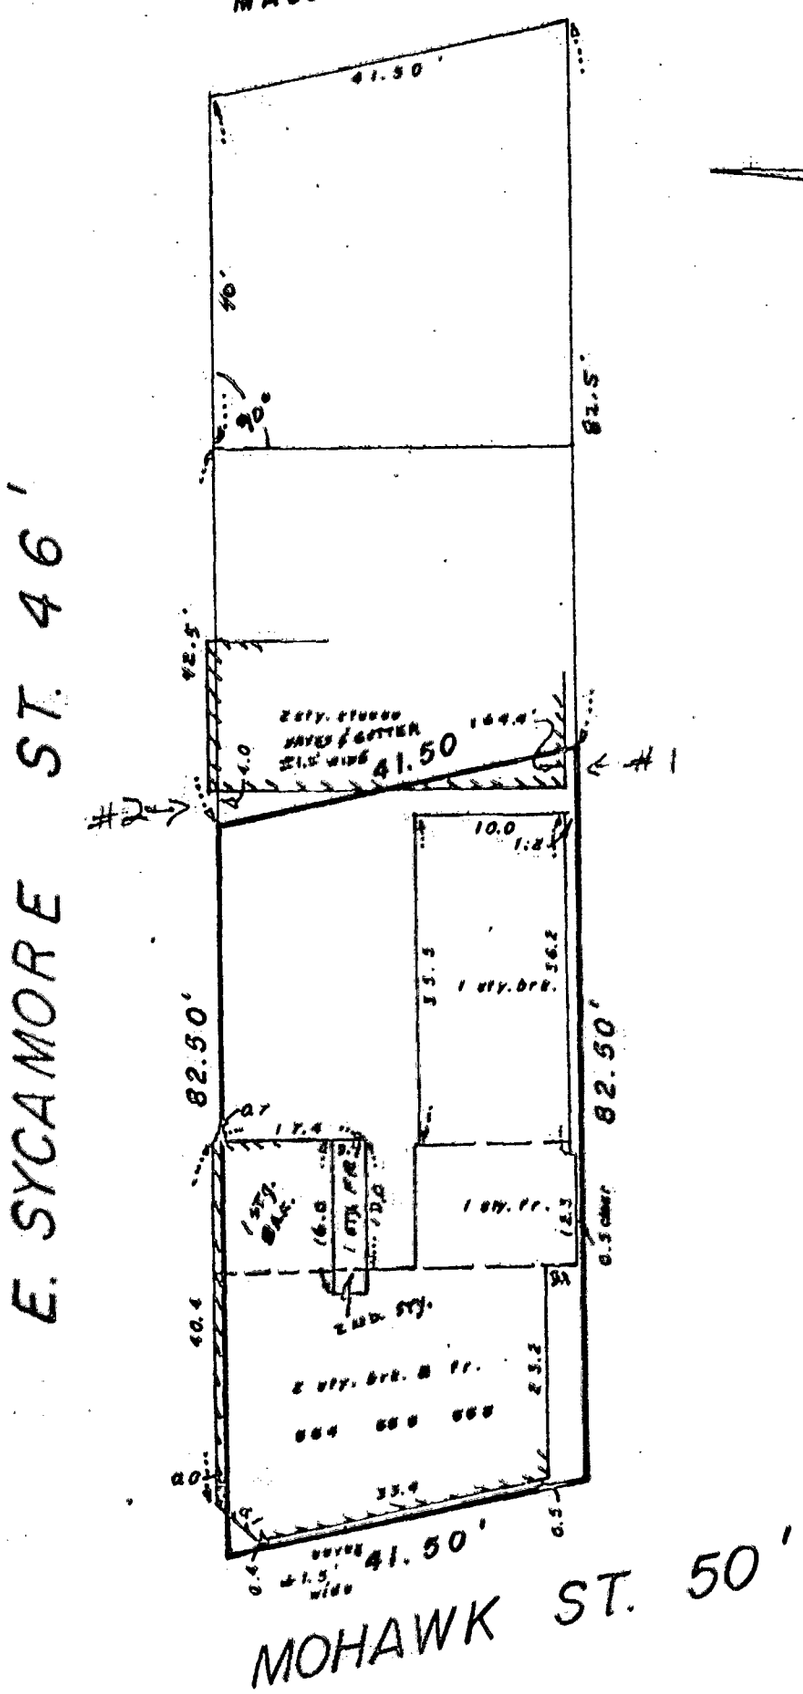

I hereby certify that the foregoing plat was prepared from an actual survey of the premises. No side line of principal building is less than dimension shown. Iron pins not set unless indicated thus —o— For Mortgage Loan & Title Insurance purposes only.

MYERS SURVEYING CO.
BY [signature]
Registered Surveyor