Myers Surveying Company, Inc.

2740 East Main Street, Columbus 43209 (Bexley), Ohio
614-235-8677 FAX: 614-235-4559

02857/00

A Boundary Survey prepared for and certified to:
Brenton E. Warner

Legal Description: Situated in Ohio, County of Franklin, City of Columbus, Being Being 0.024 Acres, part of the South Half of Lot 724 John McGown's Addition, Deed Book "G" Page 70

Applicant:

Posted Address: 556 S. 3rd Street/122-124 E. Beck Street, Columbus, Ohio

SPLIT

30' 15' 0' 30'
Scale: 1" = 30'
Date: 12-22-' 99

NOTE: No buildings or improvements located.

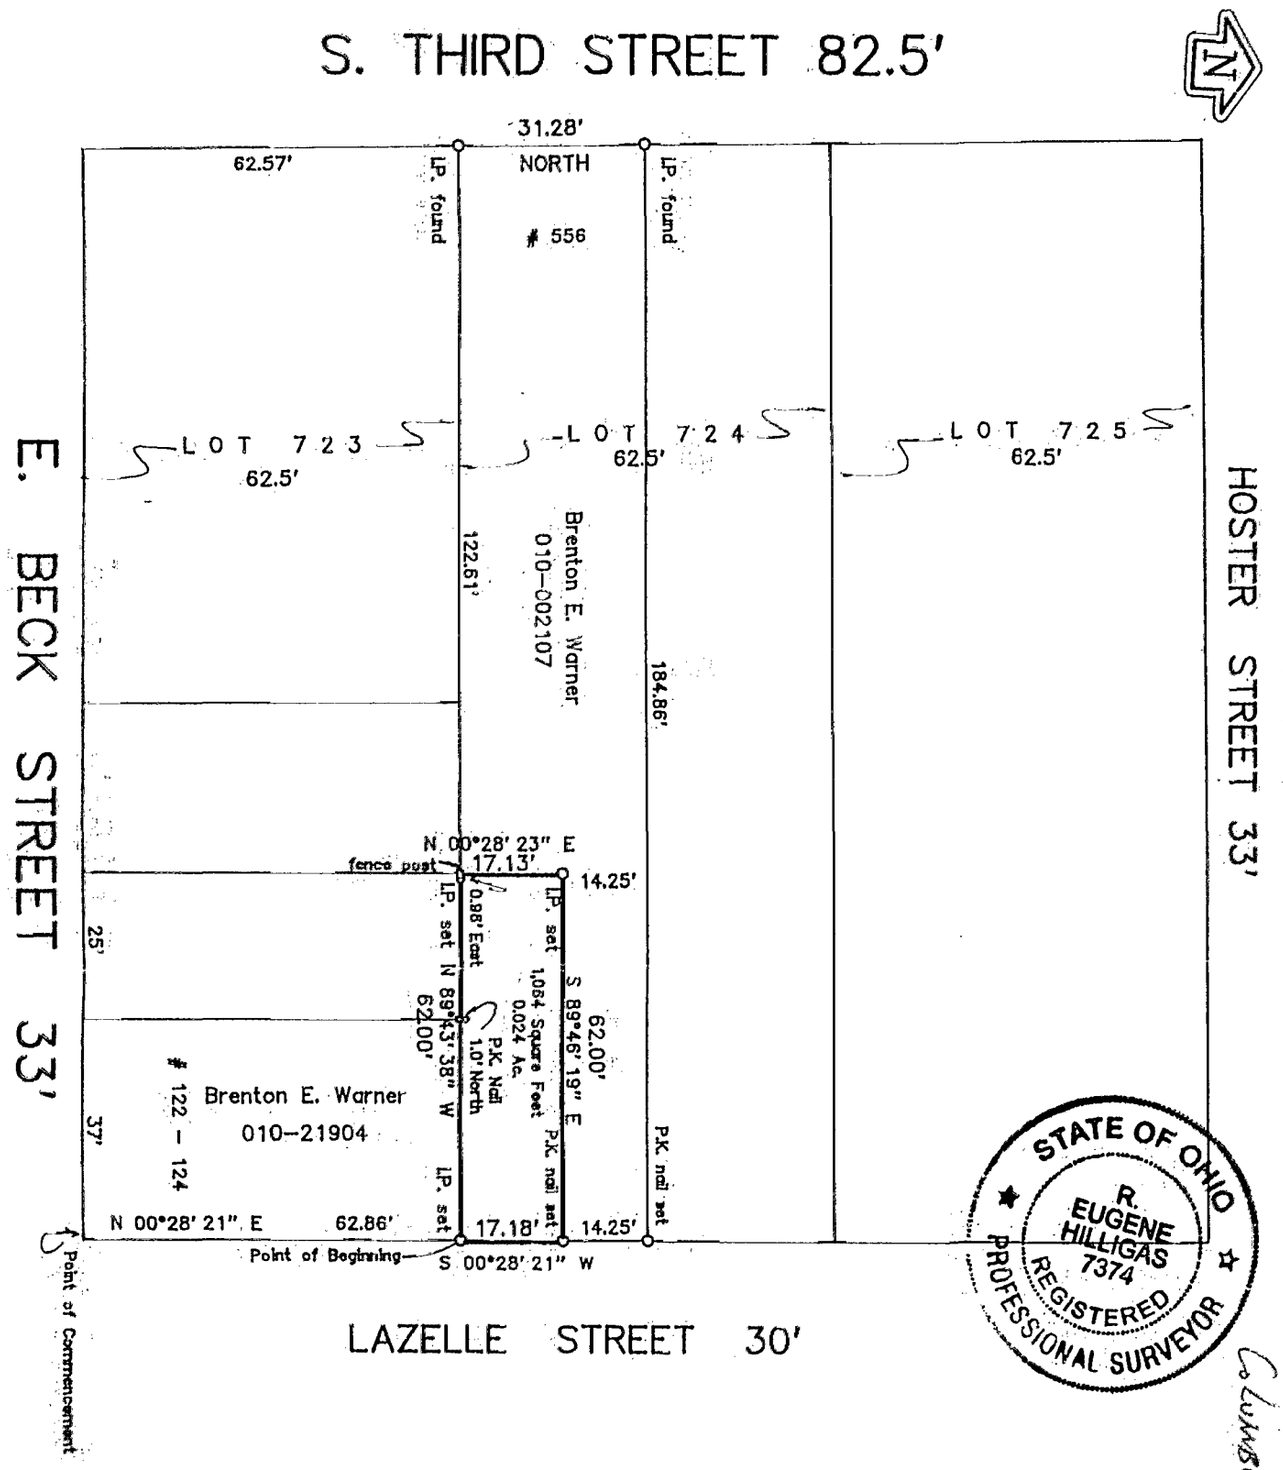

STATE OF OHIO
R. EUGENE HILLIGAS
7374
REGISTERED
PROFESSIONAL SURVEYOR

We hereby certify that the foregoing Boundary Survey was prepared from actual field measurements in accordance with Chapter 4733-37 Ohio Administrative Code. Iron pins set are 30"x1" O.D. with an orange plastic plug inscribed "P.S. 6579", unless otherwise noted. Basis of bearing is the west line of Lazelle Street assumed North 00 degrees 28 minutes 21 seconds East

Myers Surveying Co., Inc.
By R. Eugene Hilligas
Professional Surveyor

Columbus

Myers Order No. - 16-11/29/99	Rec.	Field	DWG	Ltr.	Ck.
	JPM	LG	PH	gh	PH